


T.26S. R.13 W.W.M.

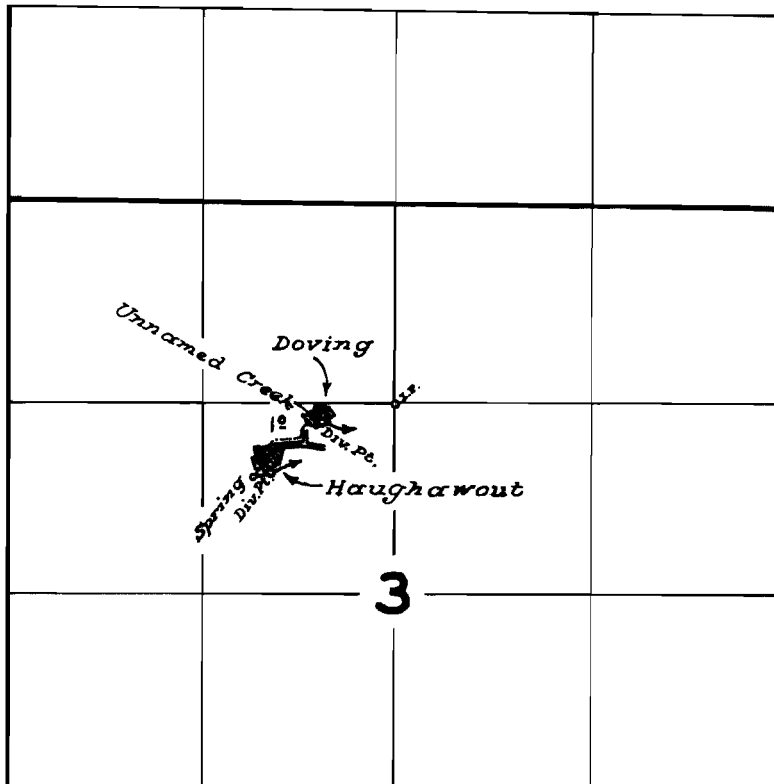

FINAL PROOF SURVEY
UNDER

Application No. 29012... Permit No. 23233.
IN NAME OF

Lefford H. & Edna Haughawout-Norman & Helen Doving

Surveyed June 9, 1960, by *R.H. Jackson*