


T.29S.R.12 W.W.M.

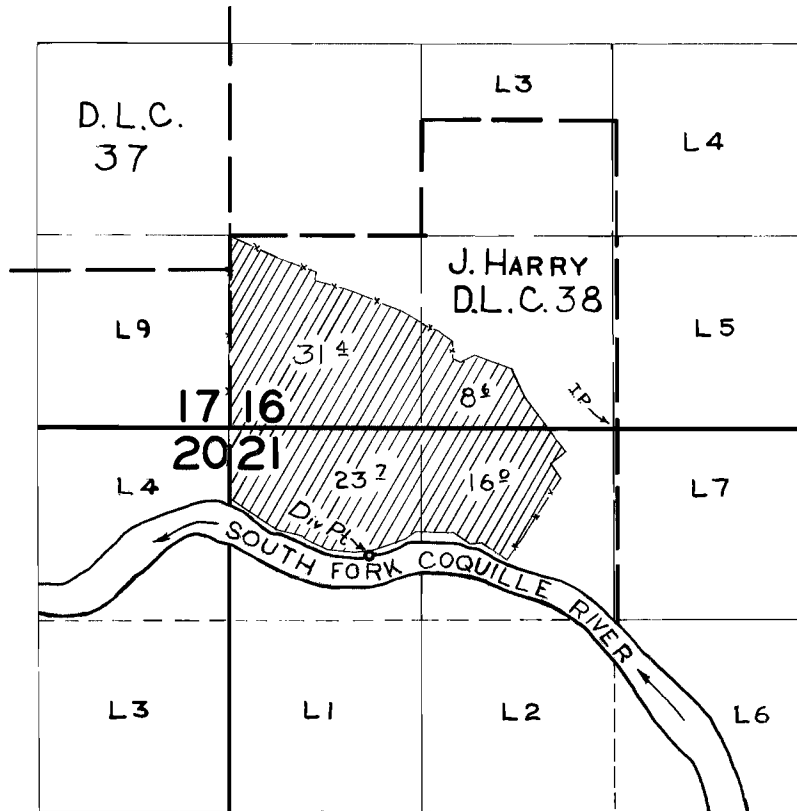

FINAL PROOF SURVEY
UNDER

Application No. 31533 Permit No. 24869
IN NAME OF

MARGUERITE LAIRD

Surveyed JUNE 7 1960, by M. BISH