


6466

See C Tp 118 R 26 E -  
see also referred to

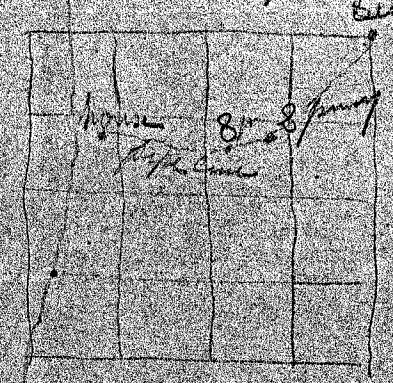

John S. Brown

OFFICE OF STATE ENGINEER  
 RECEIVED  
 APR 2 1917

Application No. 6466  
 Permit No. 4045