


T. 29S. R. 12 W. W. M.

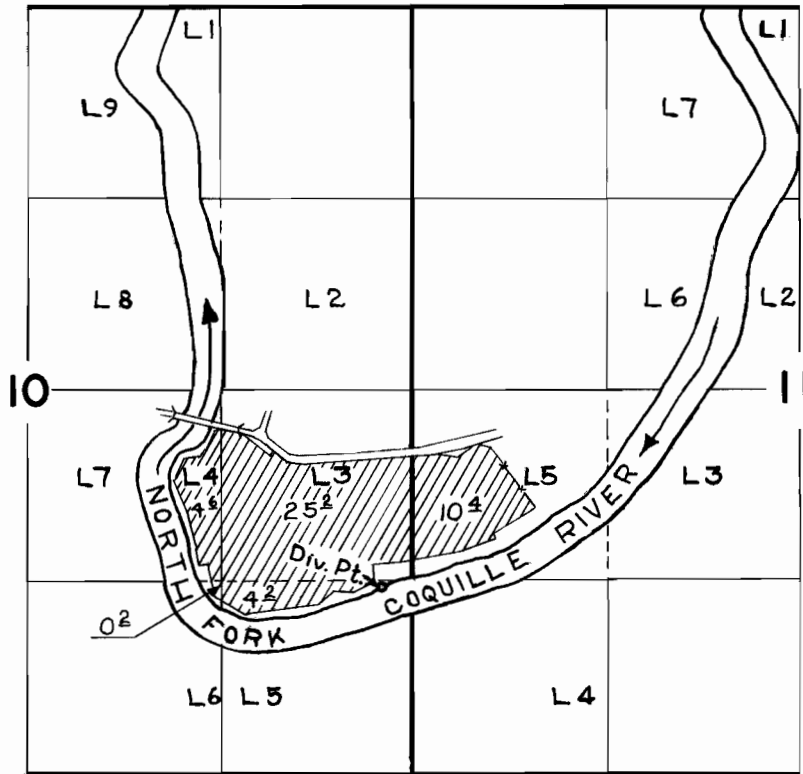

FINAL PROOF SURVEY
UNDER

Application No. 3178.1 Permit No. 250.50...
IN NAME OF

.....E. L. CULBERTSON.....

Surveyed JUNE 10 1960, by M. B. J. S. H.