


T.32S.R. 4W.W.M.

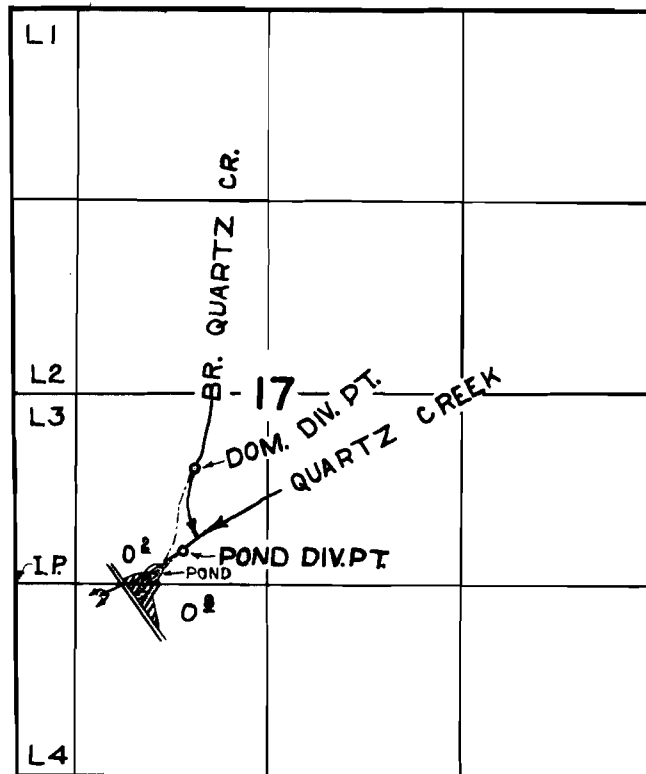

FINAL PROOF SURVEY
UNDER

Application No. 21563..... Permit No. 16944...
IN NAME OF

.....CARL M. & SHIRLEY KOEHLER.....

Surveyed JUNE 29 1960, by M. BISH.....