


T.23S.R.10W.W.M.

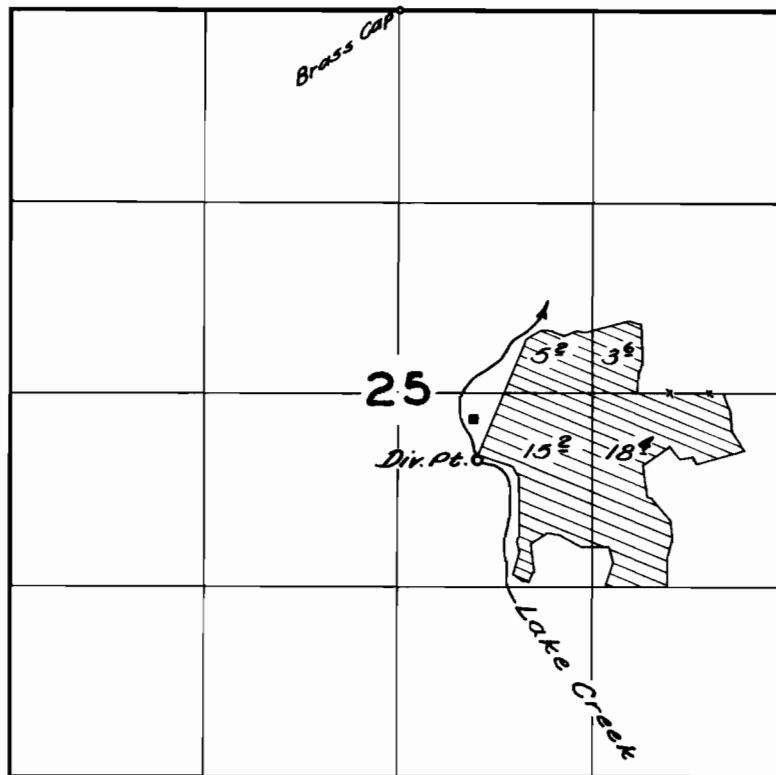

FINAL PROOF SURVEY
UNDER

Application No. 28730 Permit No. 22651
IN NAME OF

Ray E. Holliday

Surveyed June 30 1960, by C. D. Bartlett