


T. 22 S. R. 7 W. W. M.

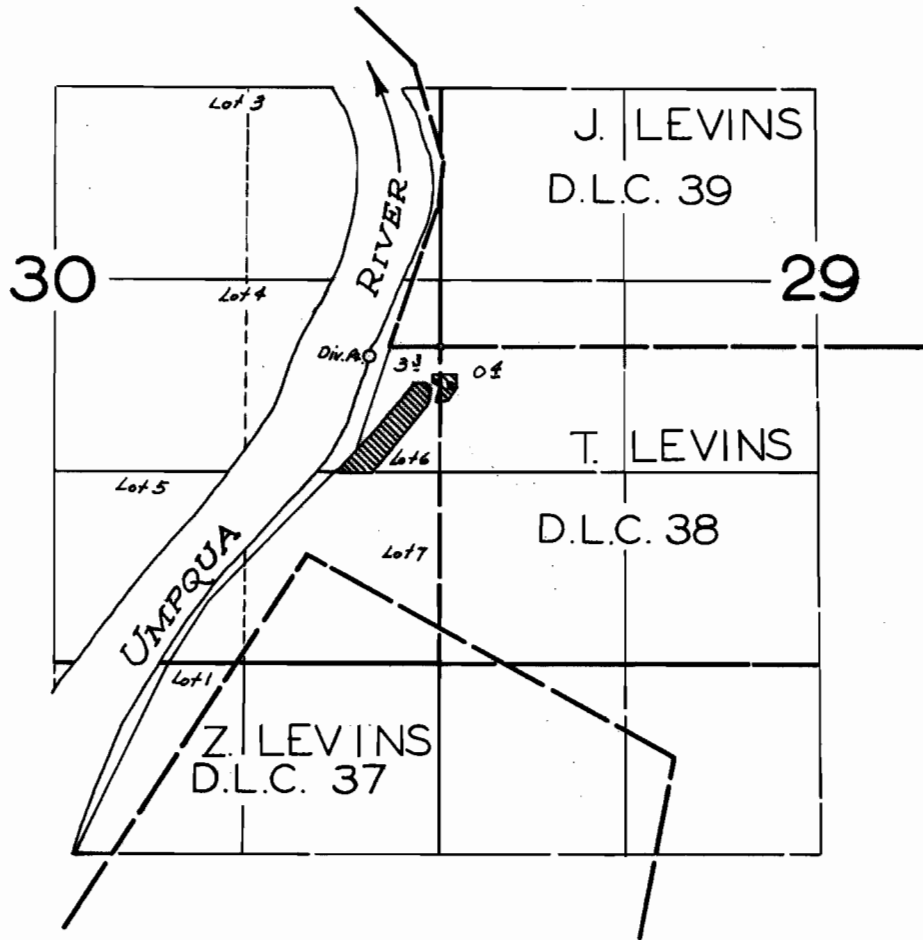

**FINAL PROOF SURVEY**  
UNDER

Application No. 29160... Permit No. 22935  
IN NAME OF

*FRANK MADISON*

Surveyed June 18, 1959, by *R.H. Jackson*  
Aug. 22, 1960 by *C.O. Bartels*