


T.20S. R.9W.W.M.

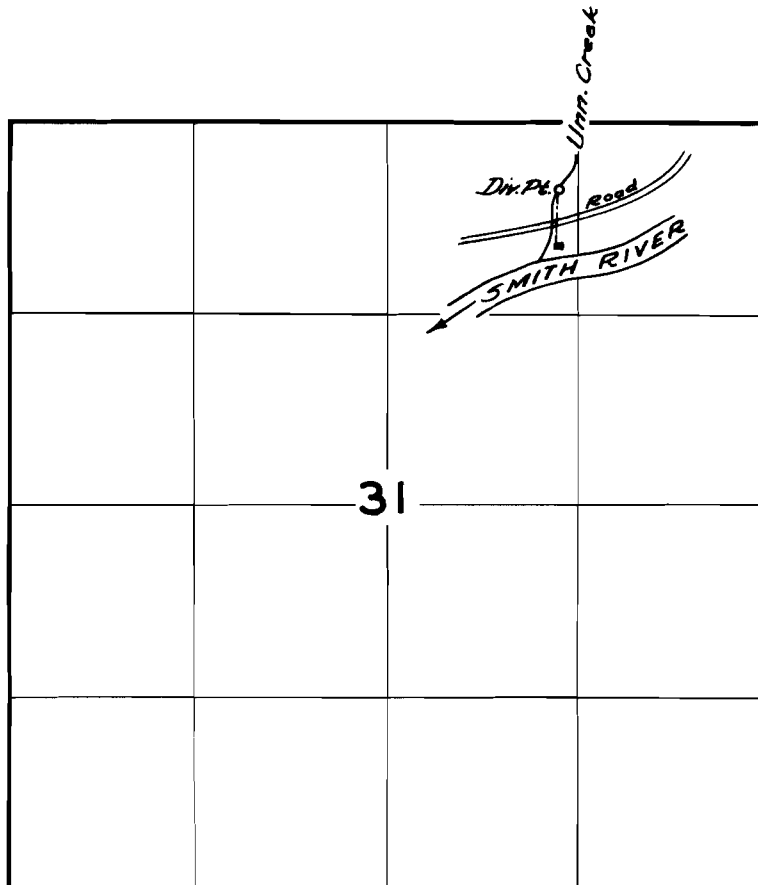

FINAL PROOF SURVEY
UNDER

Application No. 30245 Permit No. 23838
IN NAME OF

.....Chas. Lindstrom.....

Surveyed June 28 1960, by C.O. Baitels.....