


T. 30S. R. 2W.W.M.

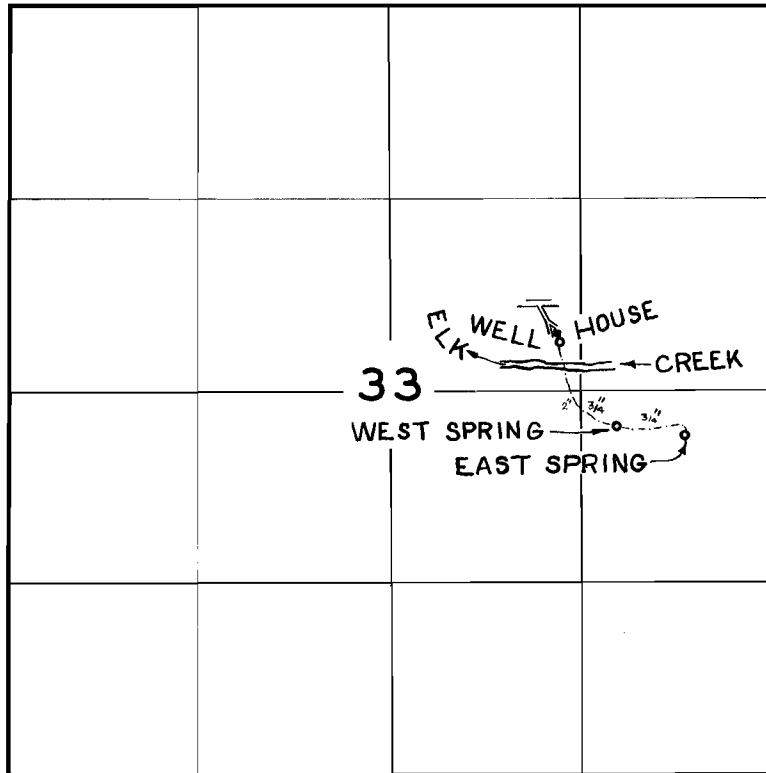


FINAL PROOF SURVEY
UNDER

Application No. 31304... Permit No. 24654...
IN NAME OF

.....ERNEST DAHACK.....

Surveyed JUNE 30 1960, by M. BISH.....

1957-A
1960-D

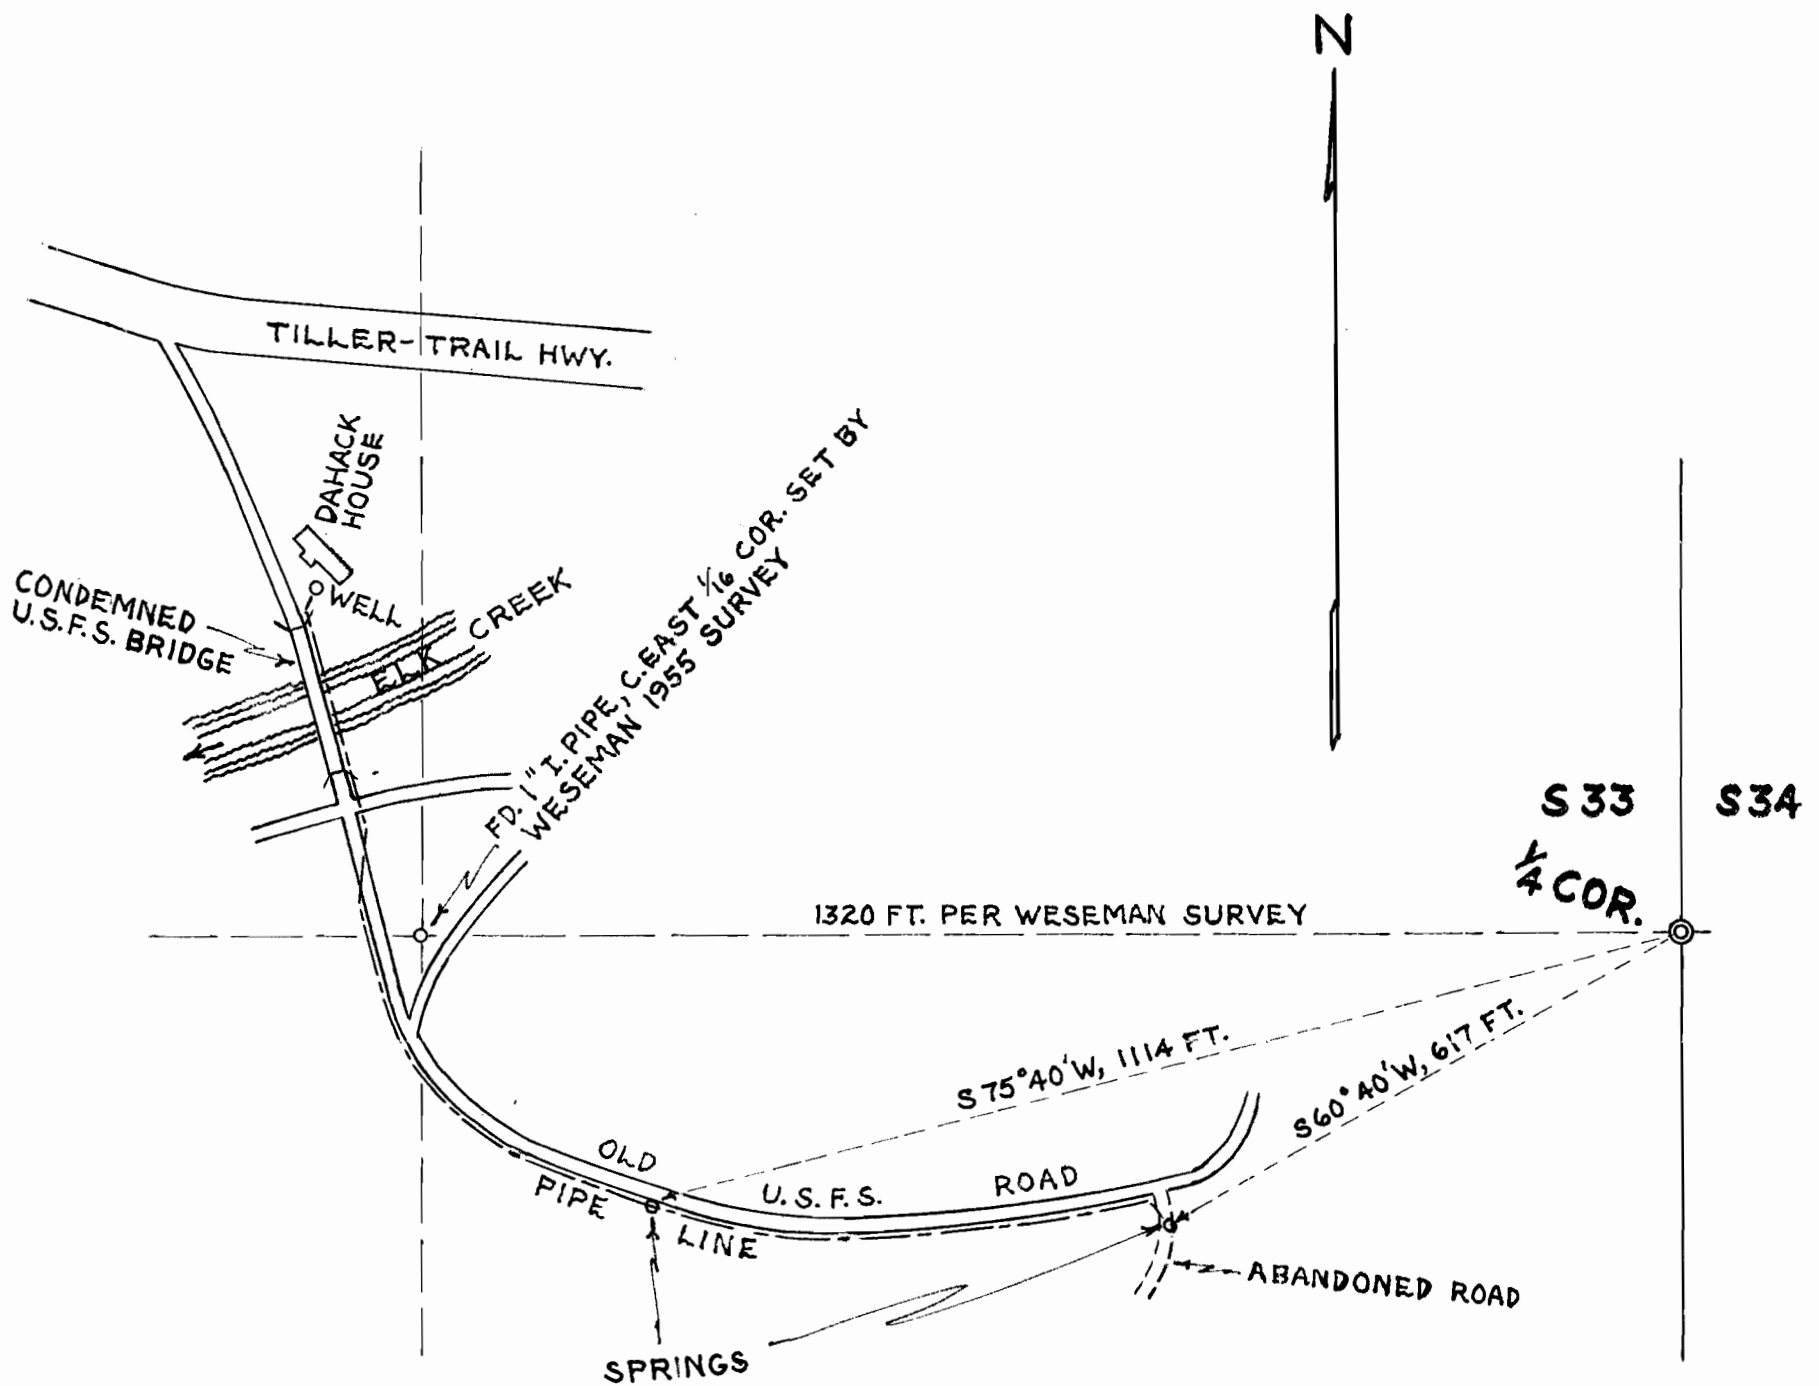

NOTE: PIPE LINE TO CARRY WATER FROM SPRINGS TO DAHACK WELL

APPLICATION FOR WATER RIGHT

FOR ERNEST DAHACK, SEC. 33, T 30 S, R 2 W, W. M.

SCALE : 1 IN. = 200 FT.

OCT. 13, 1956

R. M. THOMPSON

APPROVED BY
 31307
 21654

