


T.30S. R. 3W.W.M.

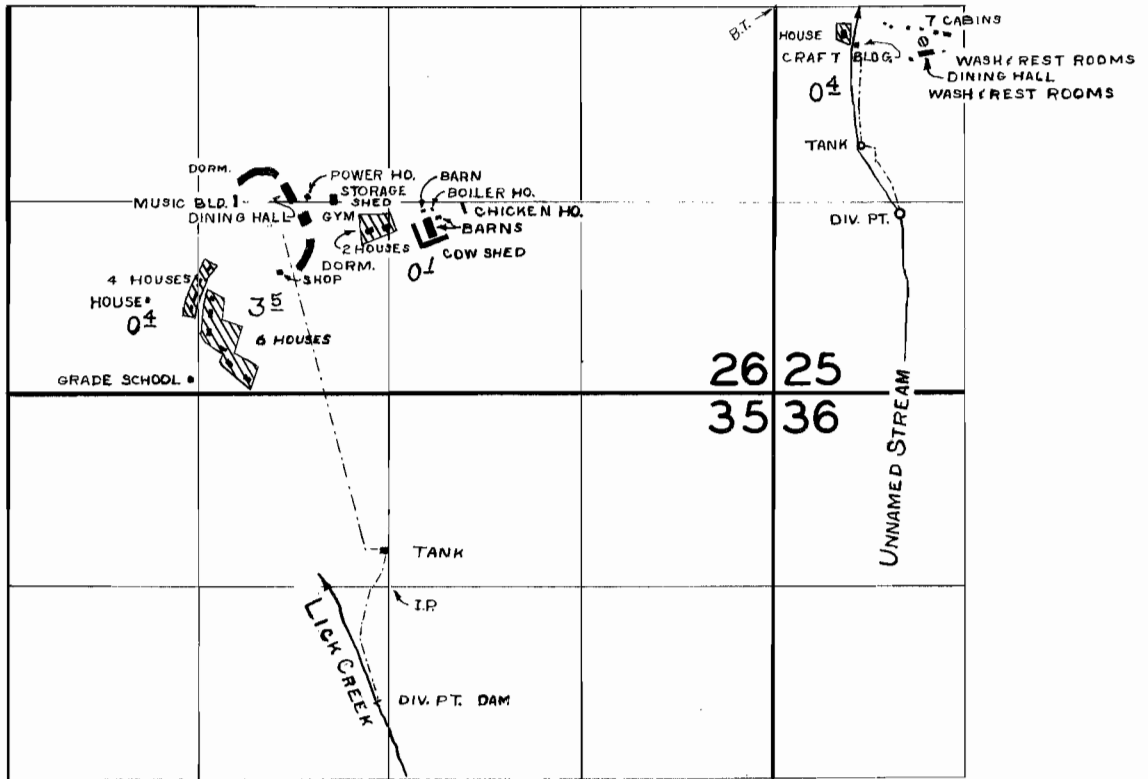

FINAL PROOF SURVEY UNDER

Application No. 31293 Permit No. 24784
 31292 24783
 IN NAME OF

MILO ACADEMY INC.

JUNE 30

Surveyed JULY 1, 1960, by M. BISH