


# T.30S. R. 3W.W.M.

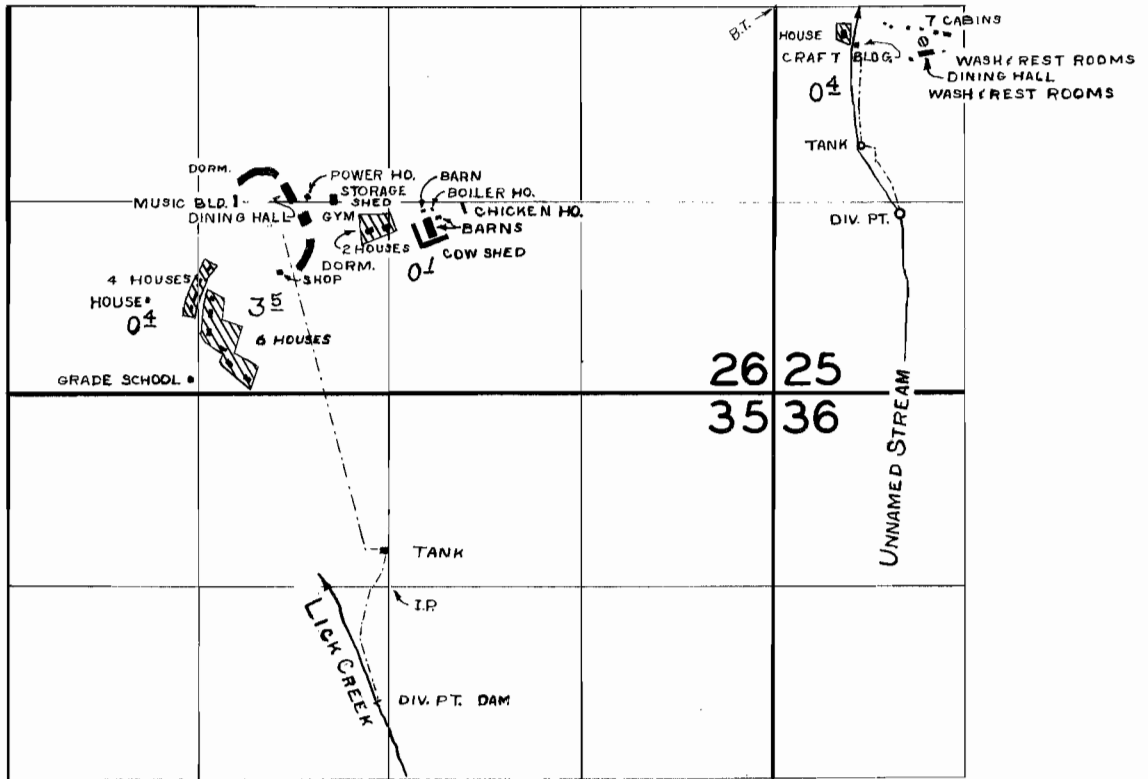

## FINAL PROOF SURVEY UNDER

Application No. 31293 ..... Permit No. 24784  
 31292 ..... 24783 .....  
 IN NAME OF

MILO ACADEMY INC.

JUNE 30

Surveyed JULY 1, 1960, by M. BISH