


T. 26S. R. 6W. W.M.

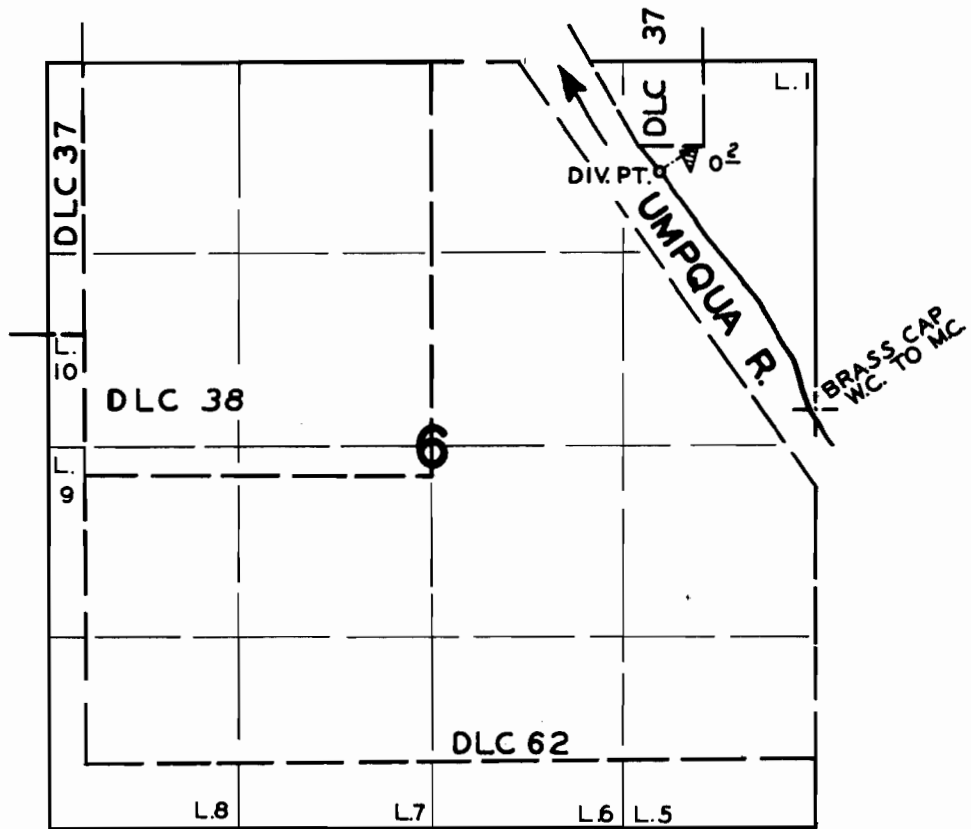

FINAL PROOF SURVEY
UNDER

Application No. 33910..... Permit No. 28718.....
IN NAME OF

CHARLIE C. BERG

Surveyed AUG. 23... 1960., by C.O. BARTELS.....