


T. 9S. R. 26E. W.M.

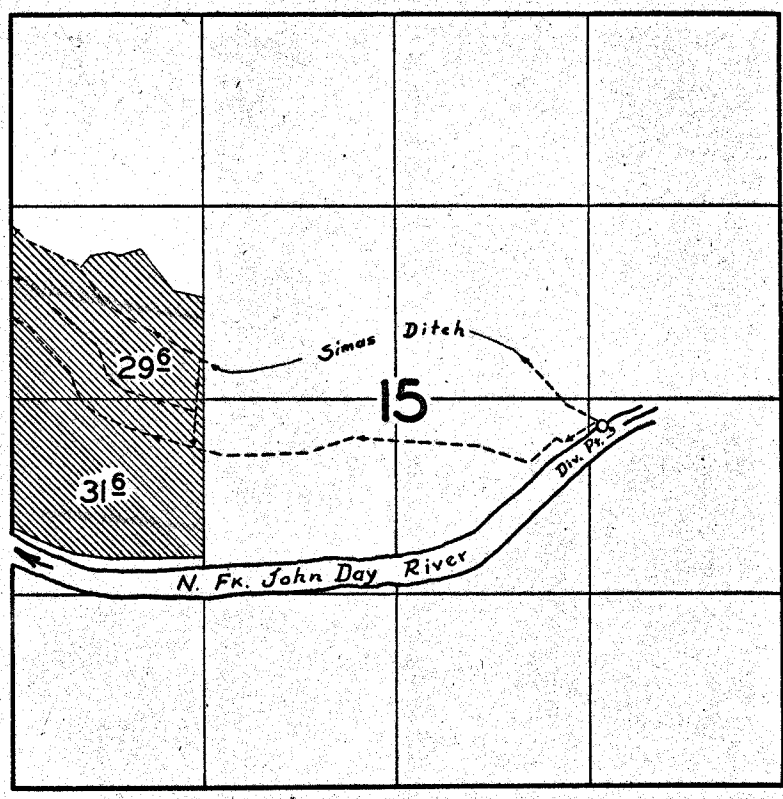

FINAL PROOF SURVEY

UNDER

Application No. 22347. Permit No. 17695

IN NAME OF

RAYMOND F. BATTY

Surveyed AUG. 13 1959, by M. BISH