


do hereby certify that the above is a true and correct copy of the original
 from profiles taken during an actual survey
 made by me on May 9th 1919 and that it
 correctly represents the work described in
 the accompanying Application together
 with the location of all streams in the
 immediate vicinity
 R. A. Bennett
 Surveyor

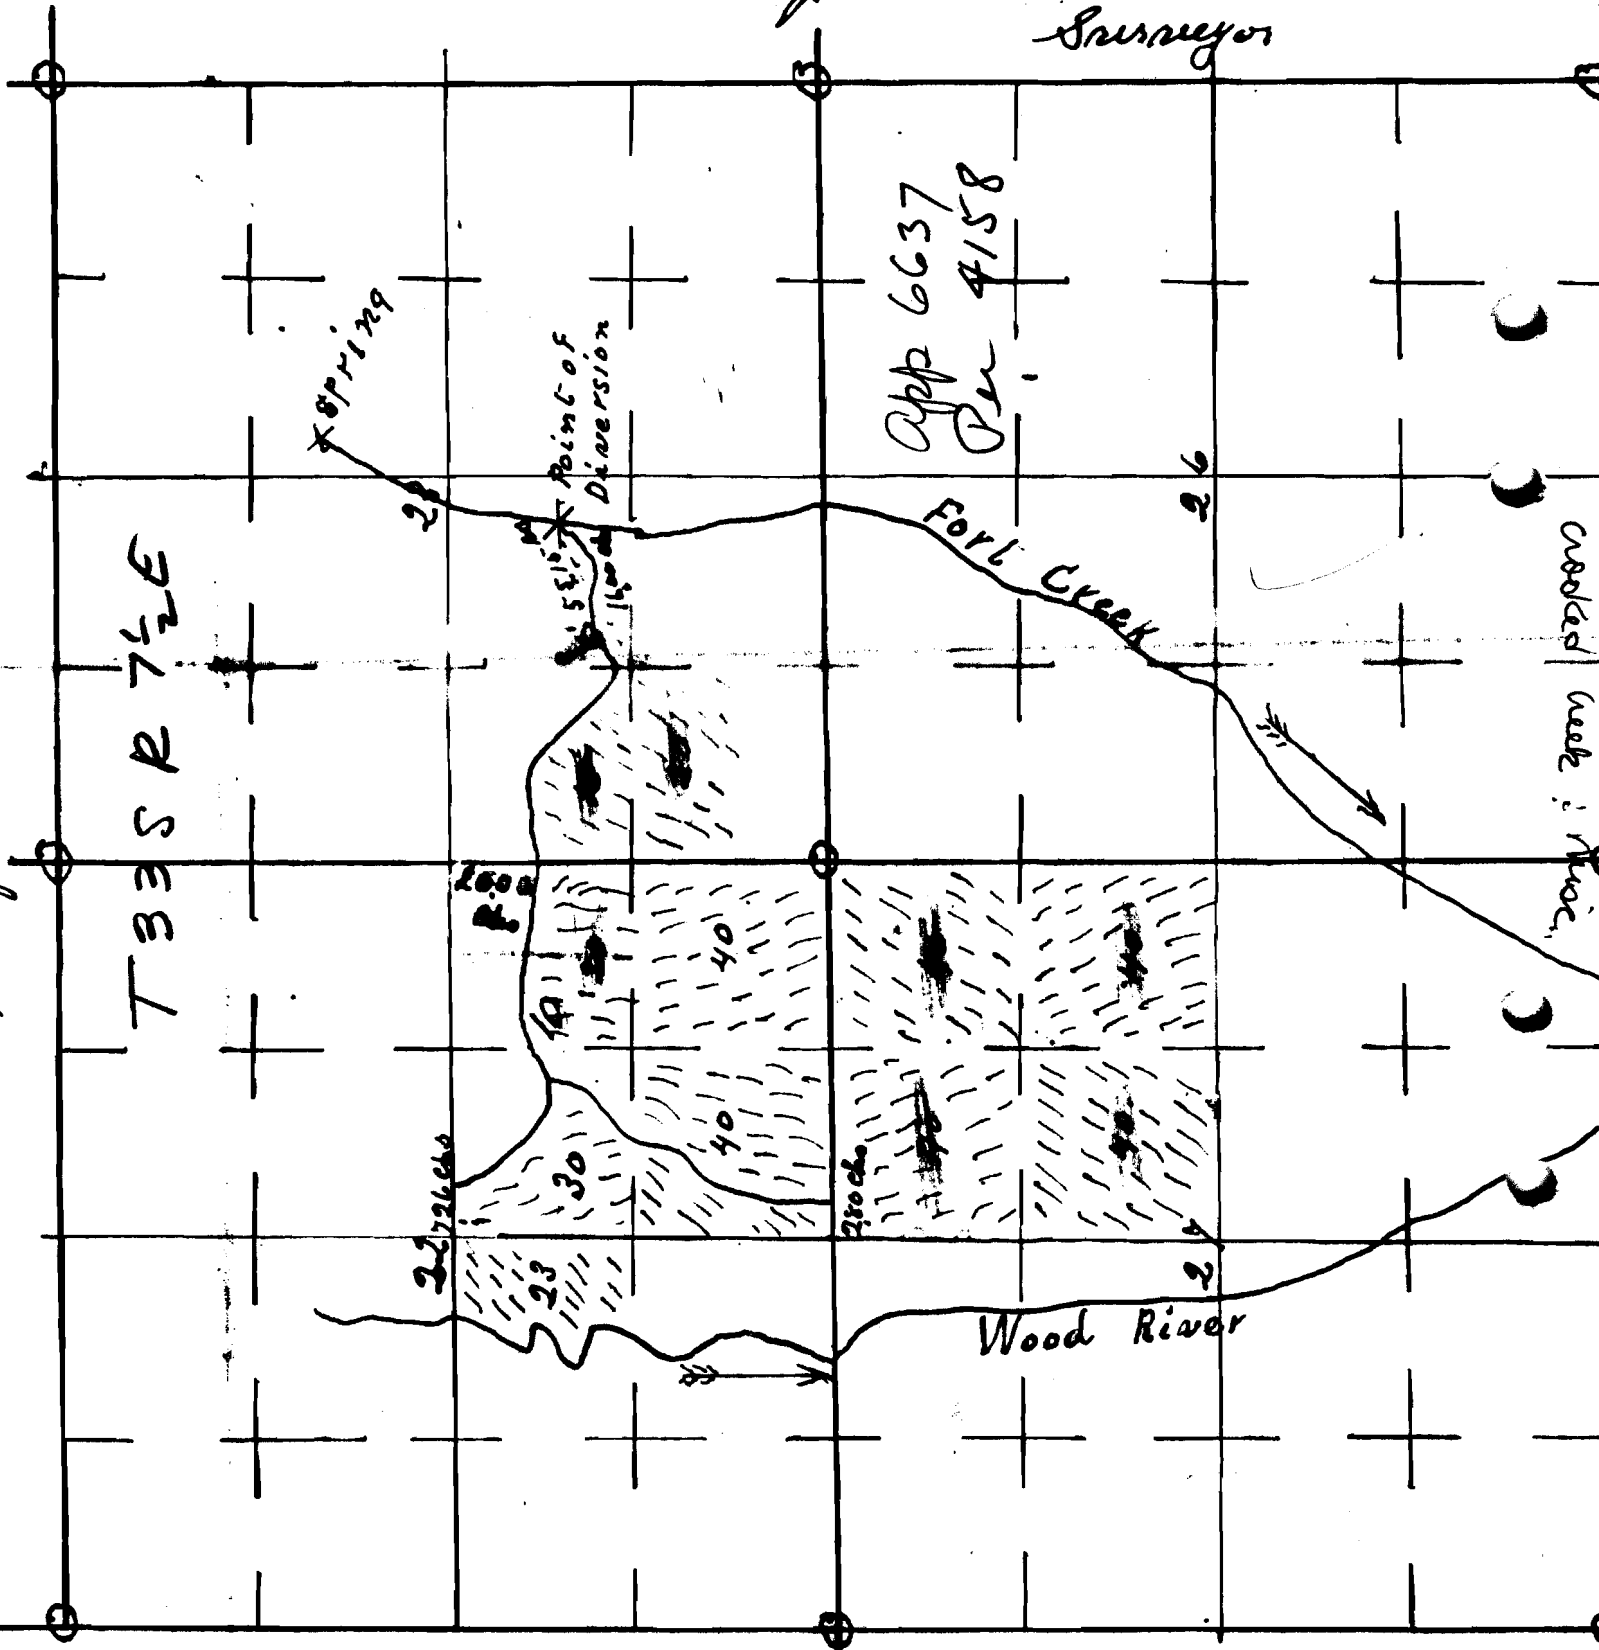

App 6637
 Per 4158

T 33 S R 7 1/2 E

2807

4158