


T. 13S. R. 27E. W.M.

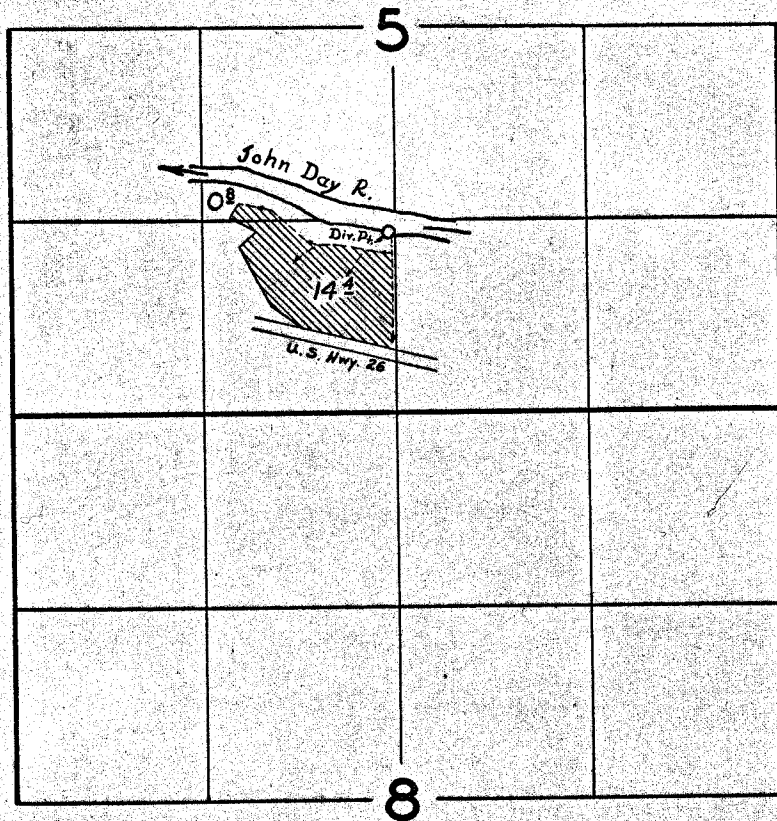

FINAL PROOF SURVEY

UNDER

Application No. 24909 Permit No. 19688

IN NAME OF

Pine Tree Lumber Co.

Surveyed Aug. 8, 1959, by M. Bish