


TWP 35 S R 4 W, WM

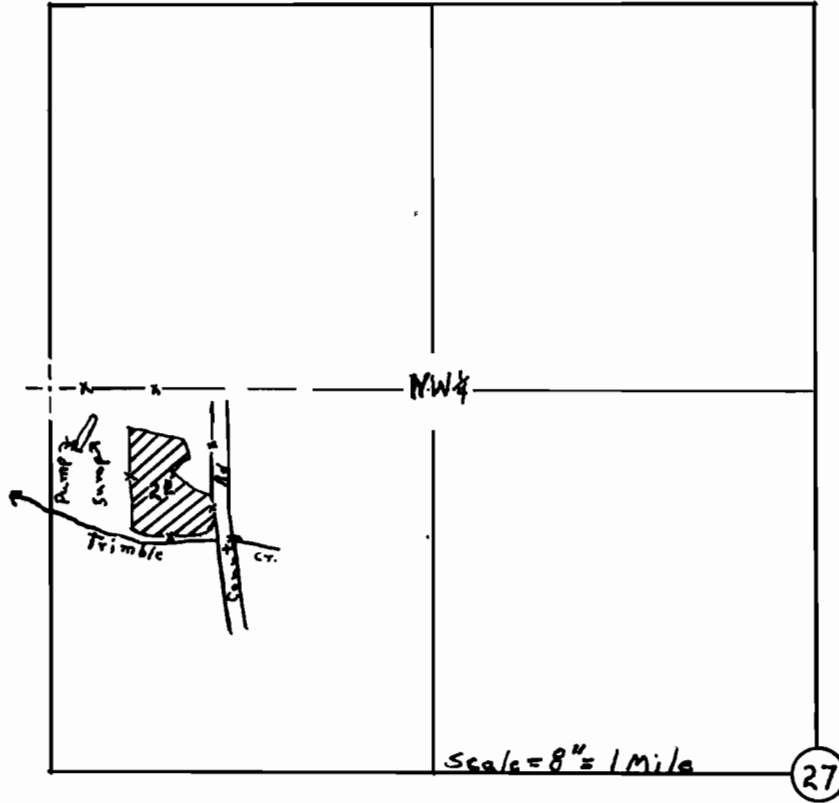

FINAL PROOF SURVEY
UNDER

Application No. G435... Permit No. G308...
IN NAME OF

.....William B. Purrier.....

Surveyed Oct 18... 1960.. by PC Hendrix.....