


T. 34 S., R. 2 W., W.M.

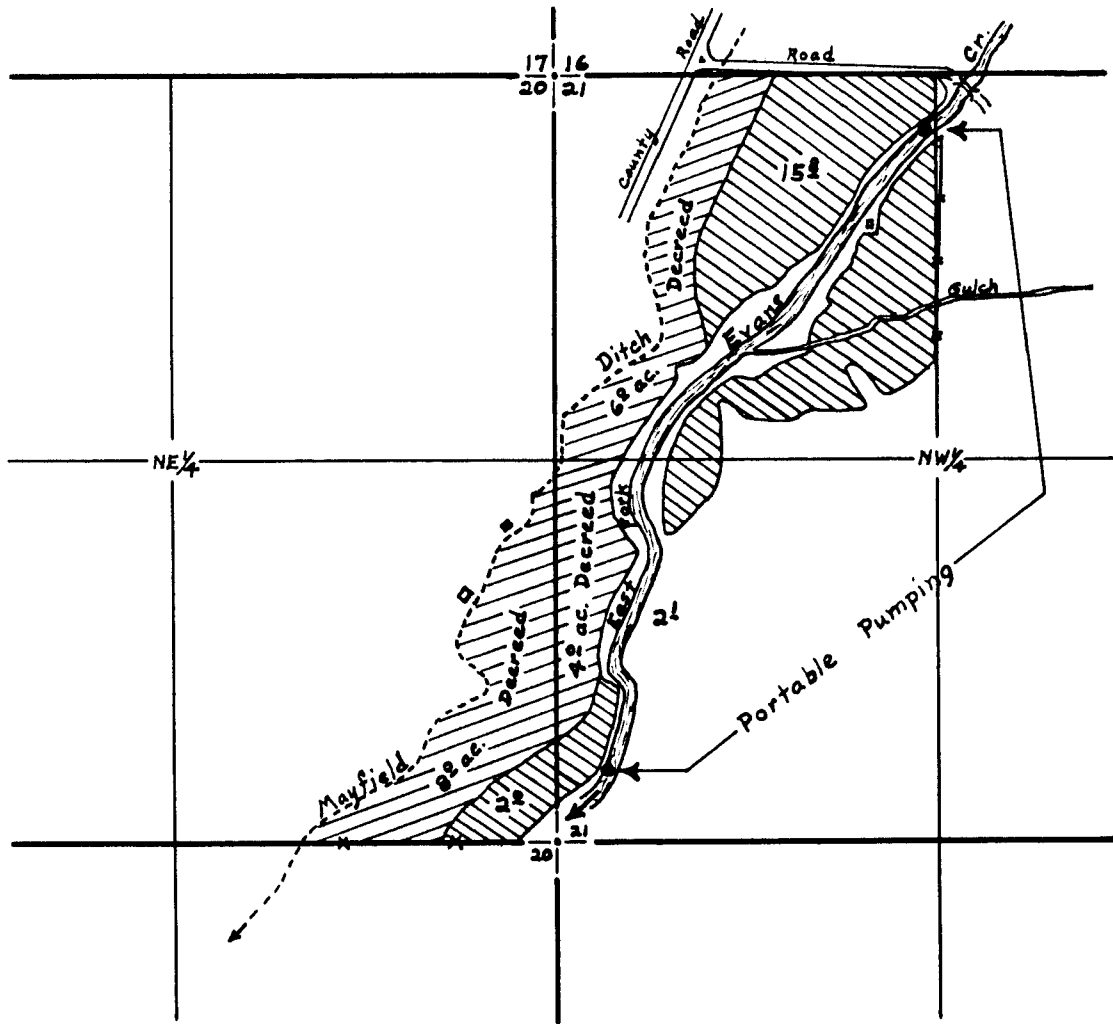

**FINAL PROOF SURVEY**  
UNDER

Application No. **26163**..... Permit No. **20422**.....  
IN NAME OF

**A. B. Singler**

Surveyed Nov. 26, 1958, by **D. C. Hendrix, W.M.**