

8 acres canceled under PC 94-3 from C-28072

T. 34 S., R. 2 W., W.M.



-NW 1/4

FINAL PROOF SURVEY
UNDER

UNDER

Application No. **26163**..... Permit No. **20422**.....
IN NAME OF


IN NAME OF

A. B. Singler

Surveyed Nov. 26, 1958, by D. C. Hendrix, WM.

Plane Table Survey

T. 34 S., R. 2 W., W.M.

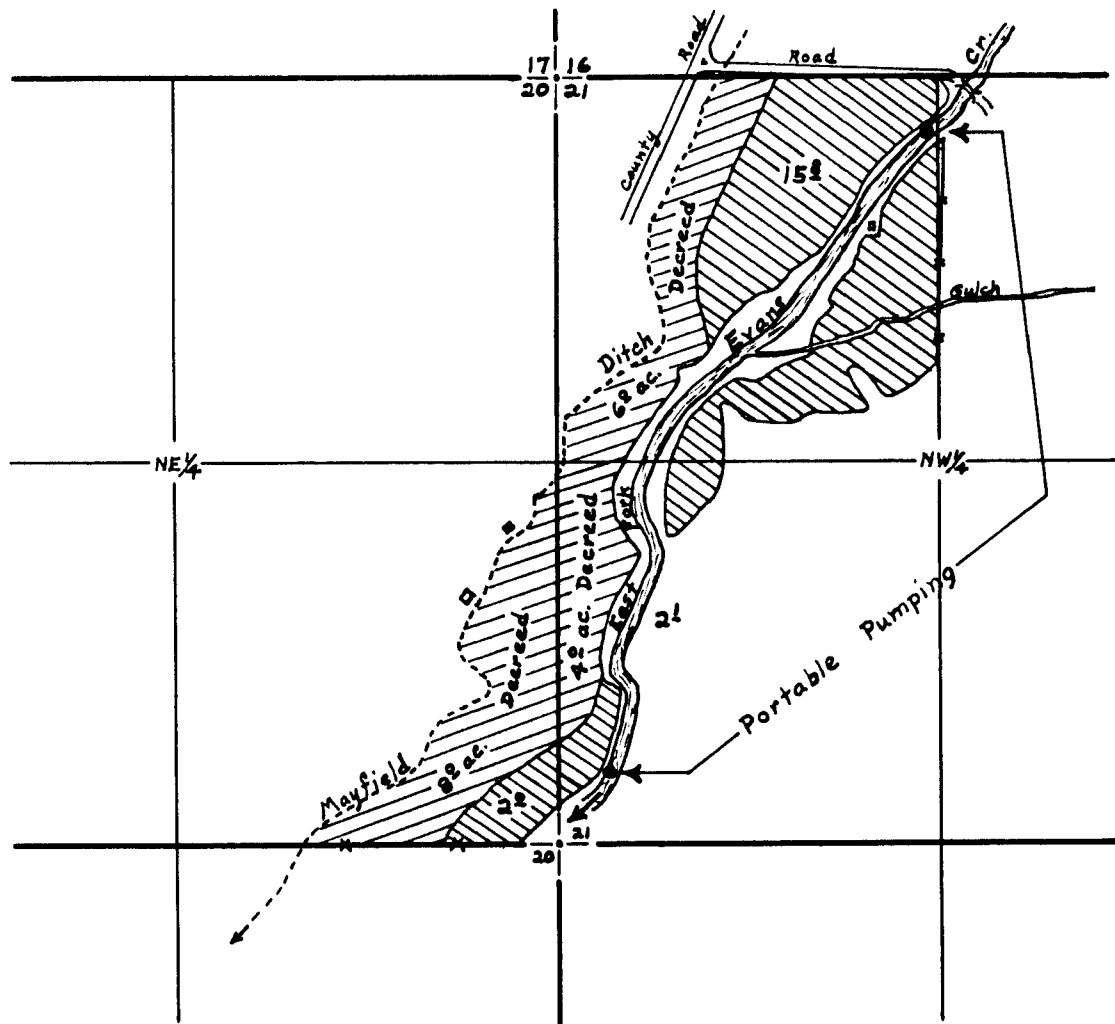

FINAL PROOF SURVEY UNDER

Application No. 26163 Permit No. 20422
IN NAME OF

A. B. Singler

Surveyed Nov. 26, 1958, by D. C. Hendrix, W.M.