


T. 38 S. R. 3 W. W. M.

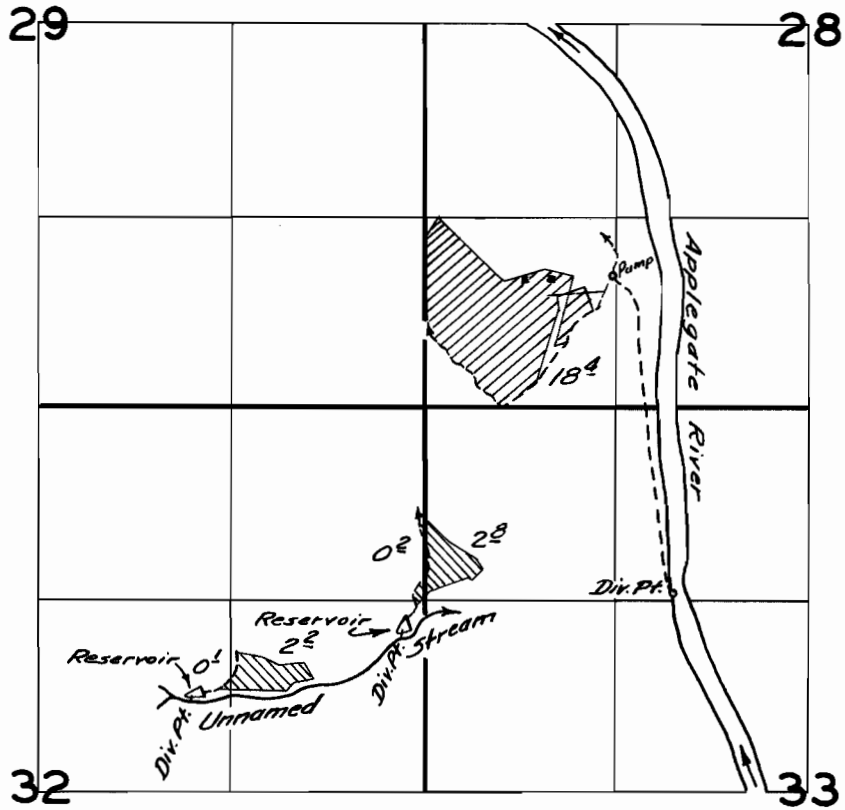

FINAL PROOF SURVEY
UNDER

Application No. ^{R-27664} 27665 Permit No. ^{R-1433} 21783
IN NAME OF

.....*Marion Dunlap*.....

Surveyed *April 11, 1960*, by *C. O. Baitha*.....