


T.36S. R.1W.W.M.

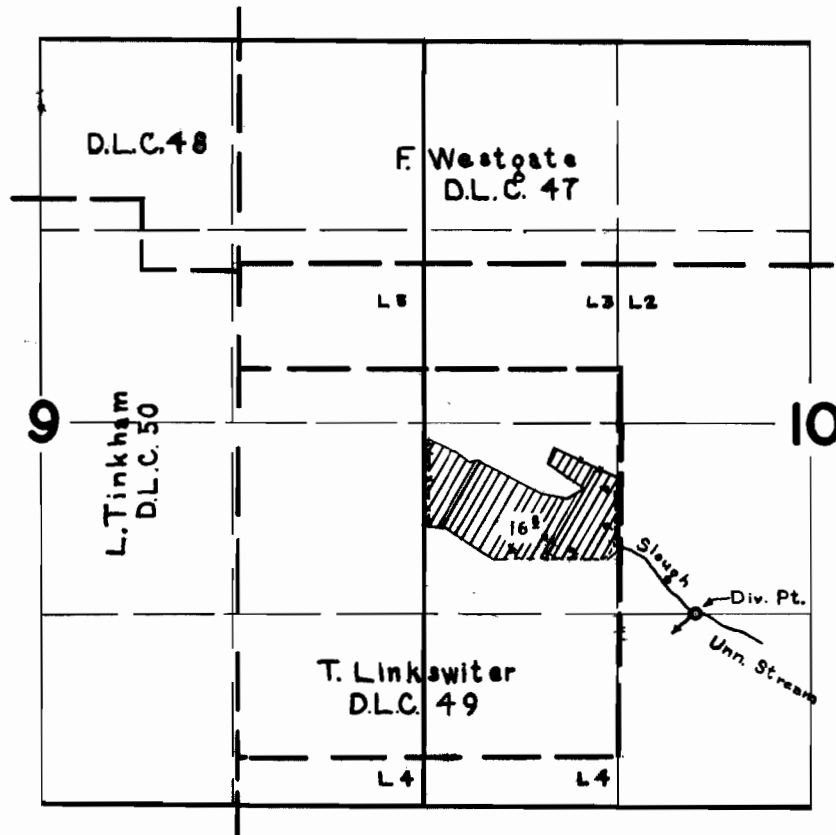

FINAL PROOF SURVEY UNDER

Application No. 31242 Permit No. 23181
IN NAME OF

Bill Alan Weed

Surveyed April 12, 1960, by M. Bish