


TWP 36 S., R 4 W., W.M.

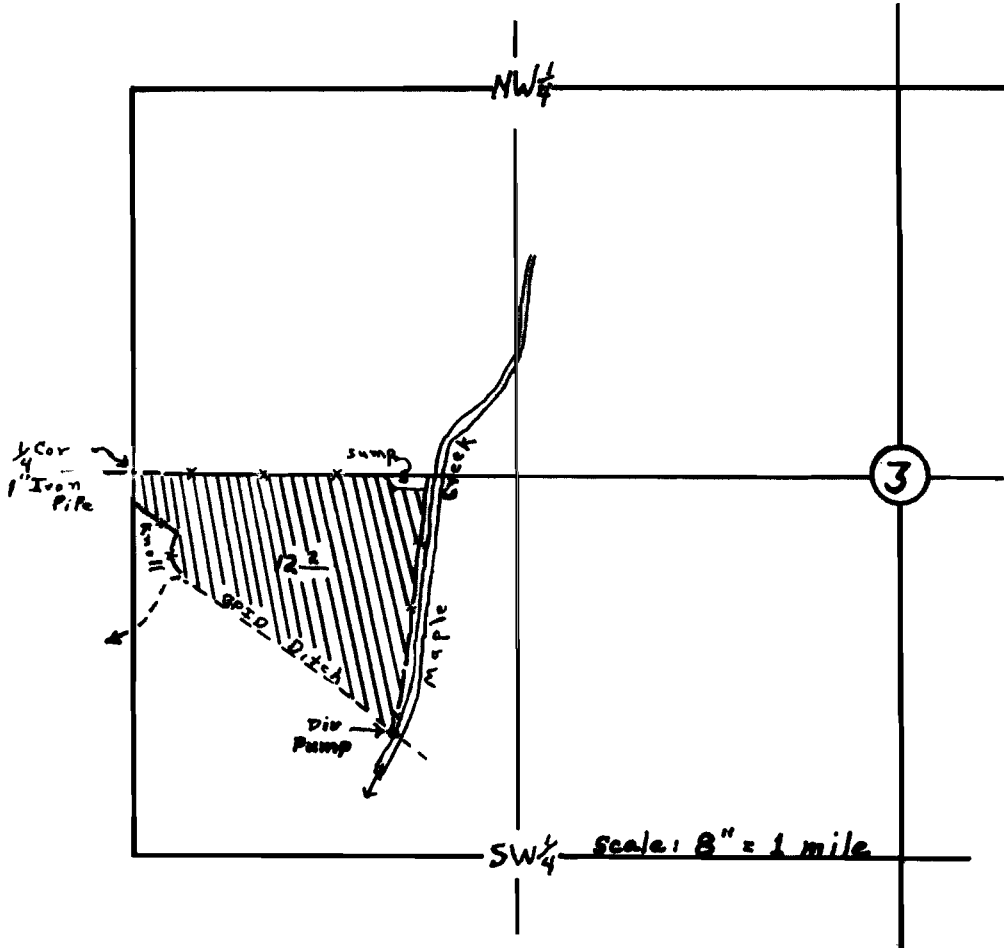

**FINAL PROOF SURVEY**  
UNDER

Application No. 32343. Permit No. 25545  
IN NAME OF

Roy Halcomb

Surveyed Oct. 19., 1960, by D.C. Hendrix.