


T. 36 S. R. 3 W. W.M.

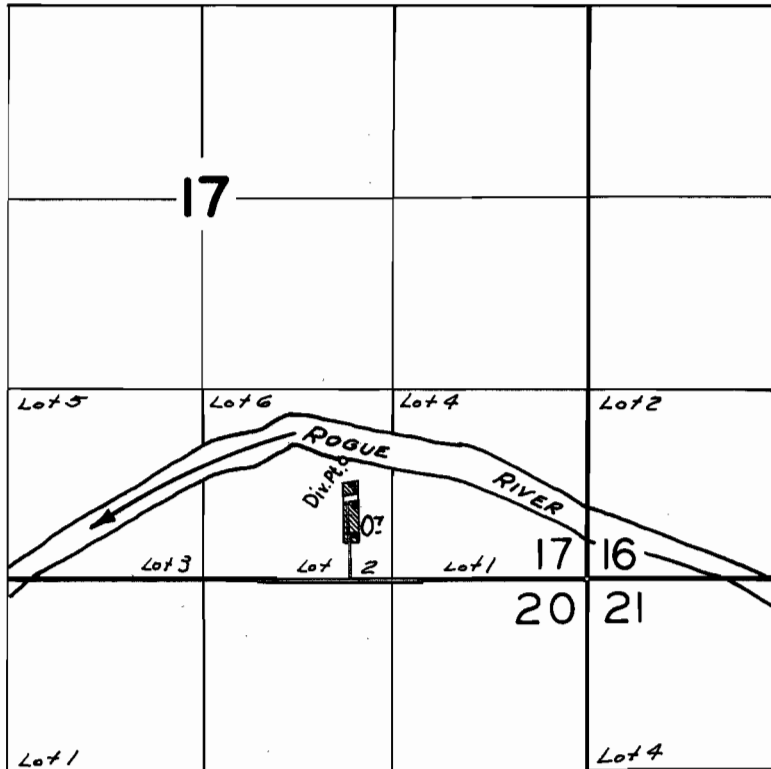

FINAL PROOF SURVEY
UNDER

Application No. 32982 Permit No. 26083
IN NAME OF

HARRY M. MCKEE

Surveyed 13 April 1960, by *W. Jackson*