


T.18S. R.2W.W.M.

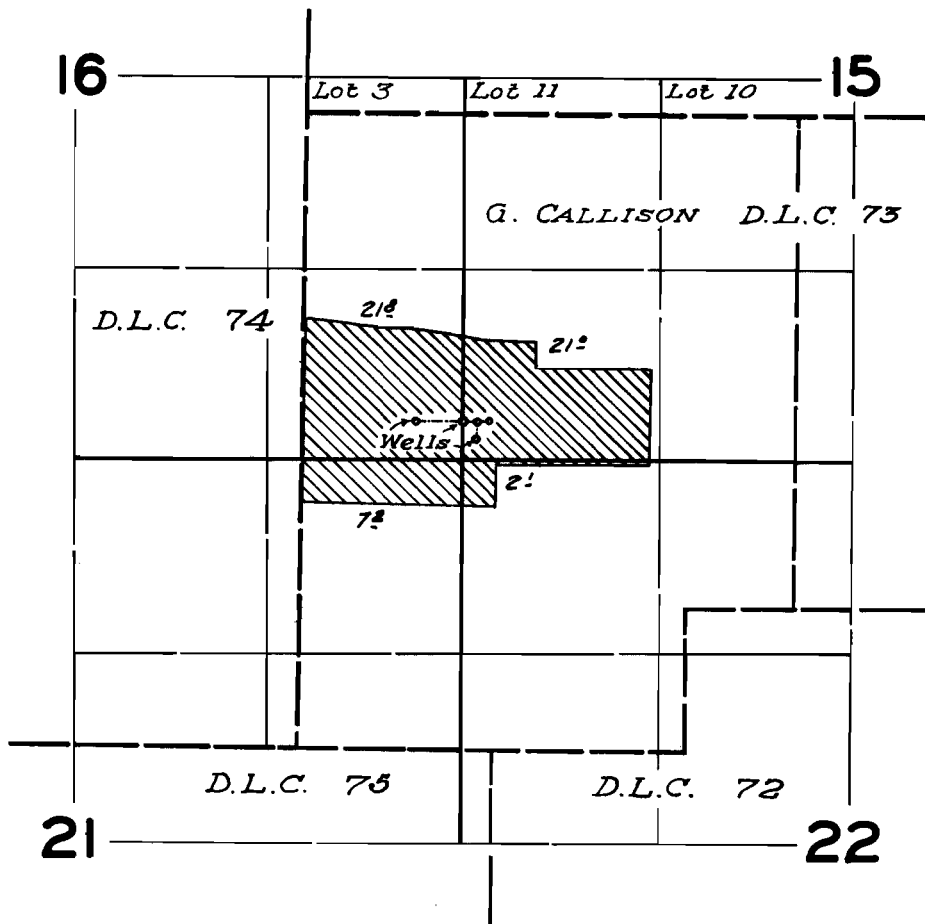

**FINAL PROOF SURVEY**  
UNDER

Application No. G-671 Permit No. G-576  
IN NAME OF

RAYMOND E. KERR

Surveyed May 11 1960, by R. Jackson