


T.16S.R.4W.W.M.

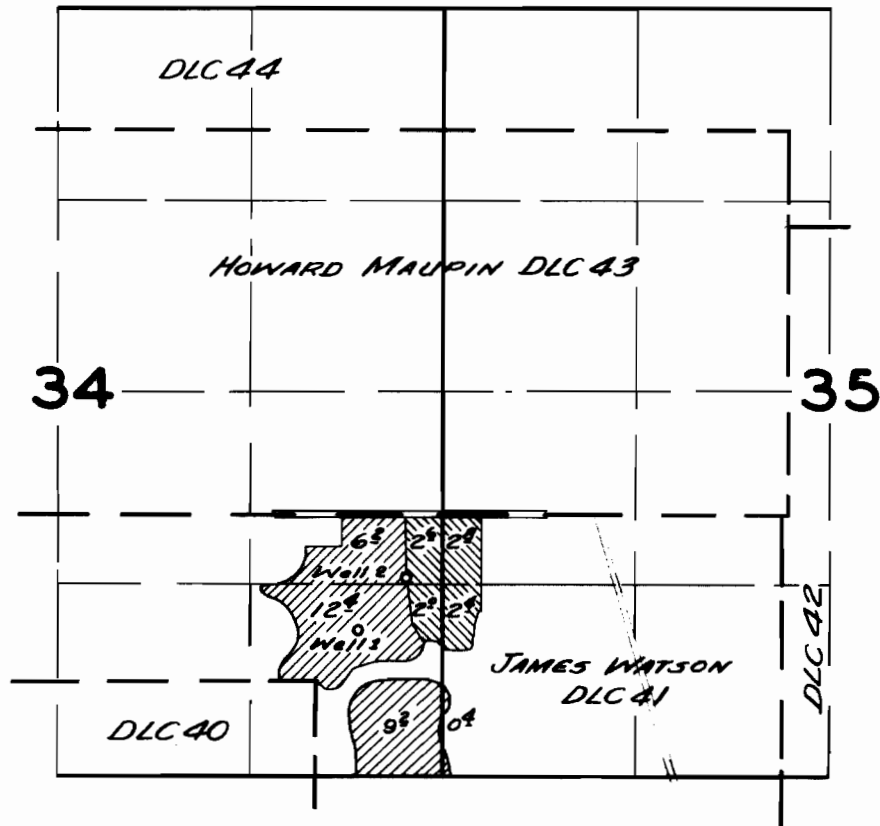

FINAL PROOF SURVEY
UNDER

Application No. G-264 Permit No. G-766
IN NAME OF

.....Nathan Lemert.....

Surveyed May 4 1960, by C.O. Baitala.....