


T.17S.R.4W.W.M.

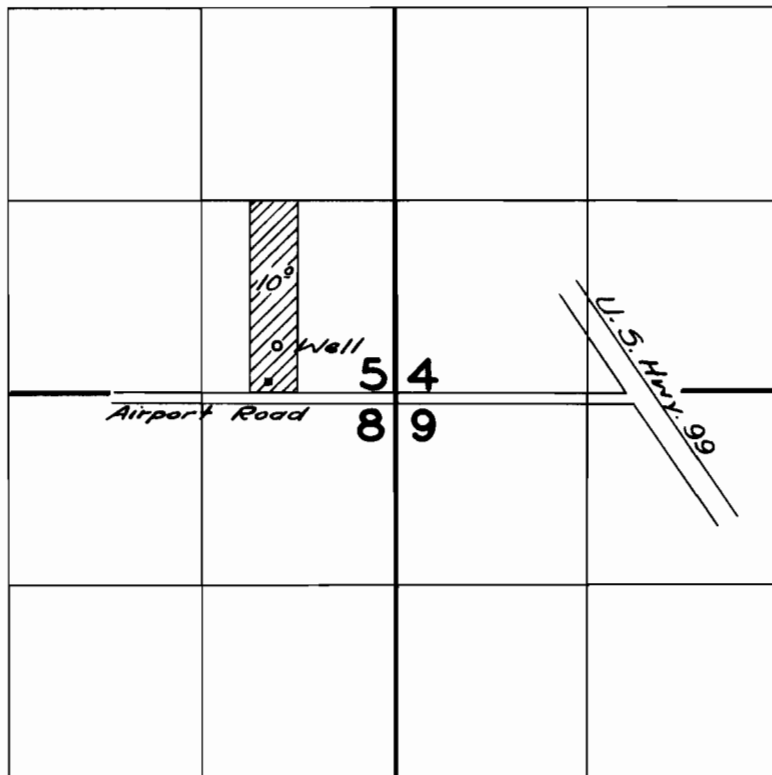

FINAL PROOF SURVEY UNDER

Application No. *G-1034*... Permit No. *G-1024*...
IN NAME OF

.....*Julian B. Falk*.....

Surveyed *April 25 1960*, by *C.O. Bartels*.....