


T.19S. R.5W.W.M.

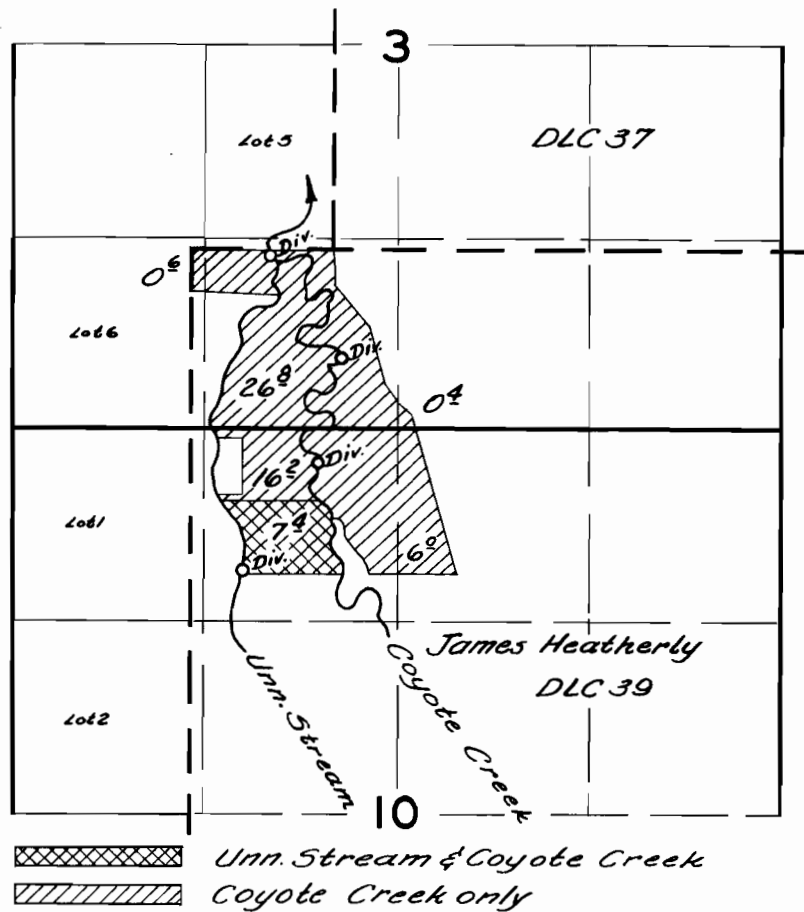

FINAL PROOF SURVEY
UNDER

Application No. 25736 Permit No. 20261..
IN NAME OF

Myrtle E. Harwood

Surveyed May 4 1960, by C.O. Bartels