


T. 18S. R. 2&3W. W.M.

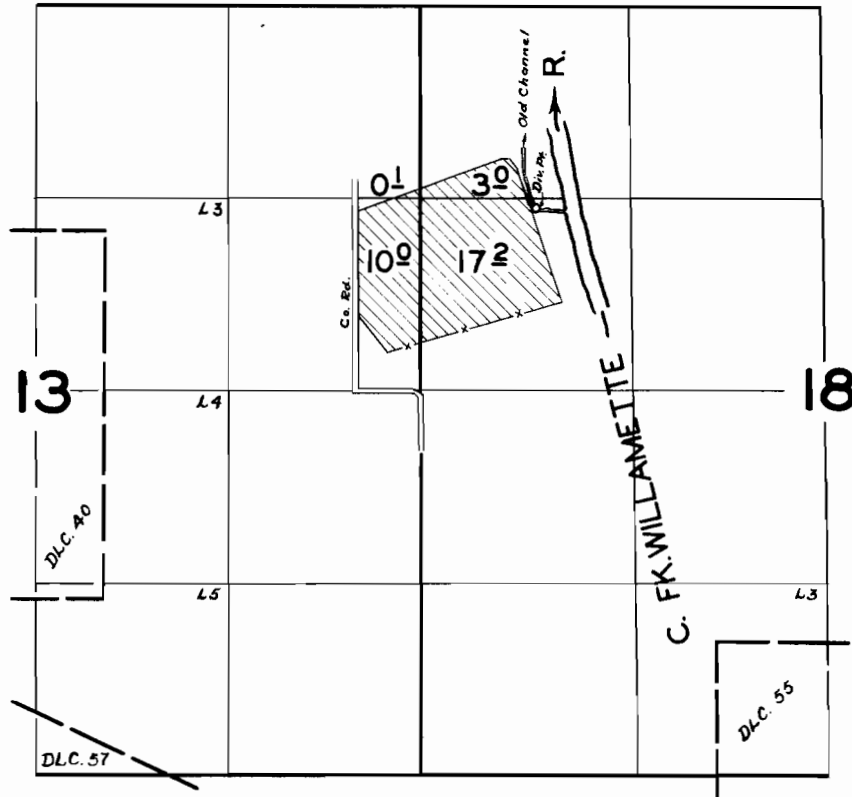

FINAL PROOF SURVEY
UNDER

Application No. 30460 Permit No. 23992
IN NAME OF

N.M. LASSEN

Surveyed MAR. 24 1959, by M. BISH