


T.18 S. R.2 W.W.M.

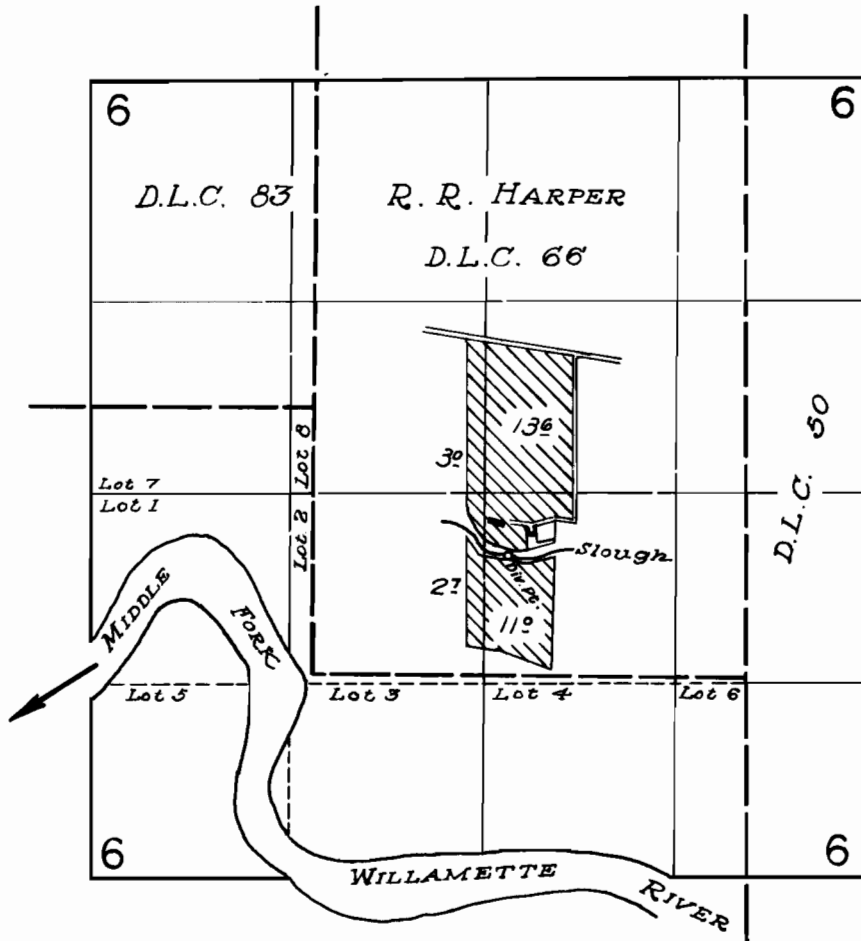

**FINAL PROOF SURVEY**  
UNDER

Application No. 30932. Permit No. 24344  
IN NAME OF

R. N. COOK

Surveyed May 3, 1960, by R. H. Jackson