


T.18S. R. 2 & 3 W.W.M.

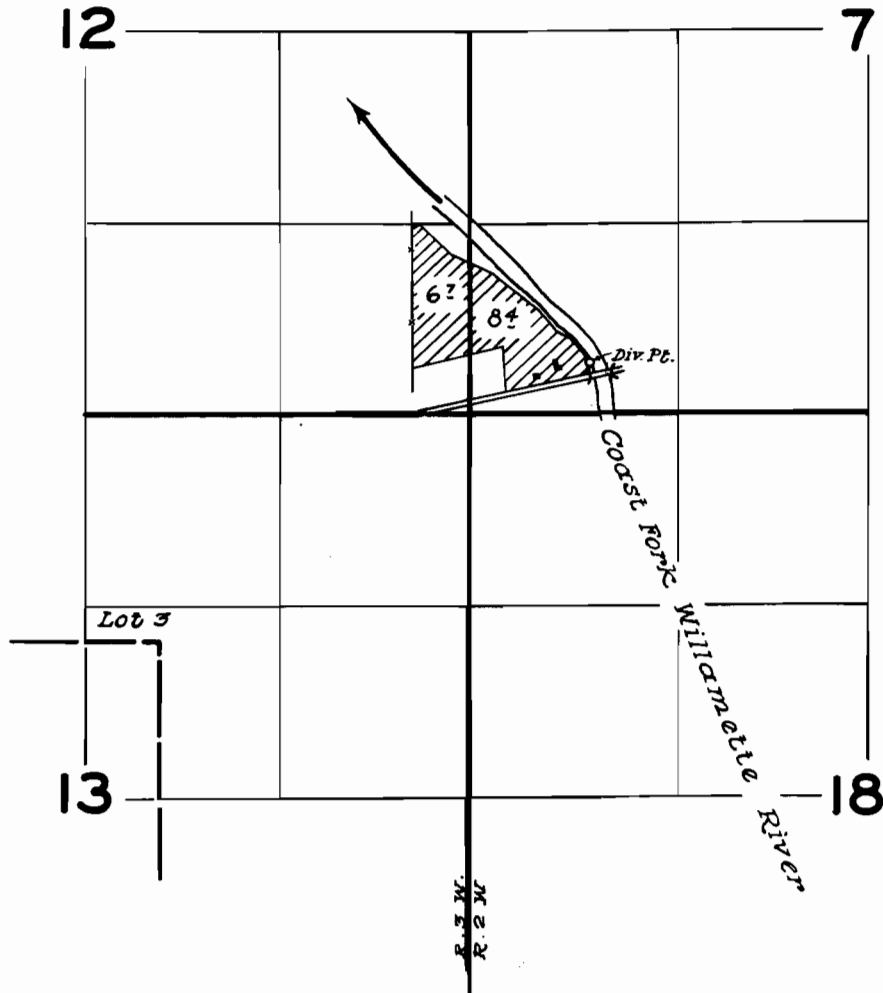

FINAL PROOF SURVEY
UNDER

Application No. 31172... Permit No. 24566...
IN NAME OF

W.G. & INA M. SAUNDERS

Surveyed May 9... 1960, by *R.H. Jackson*