


T.18S.R.2E.W.M.

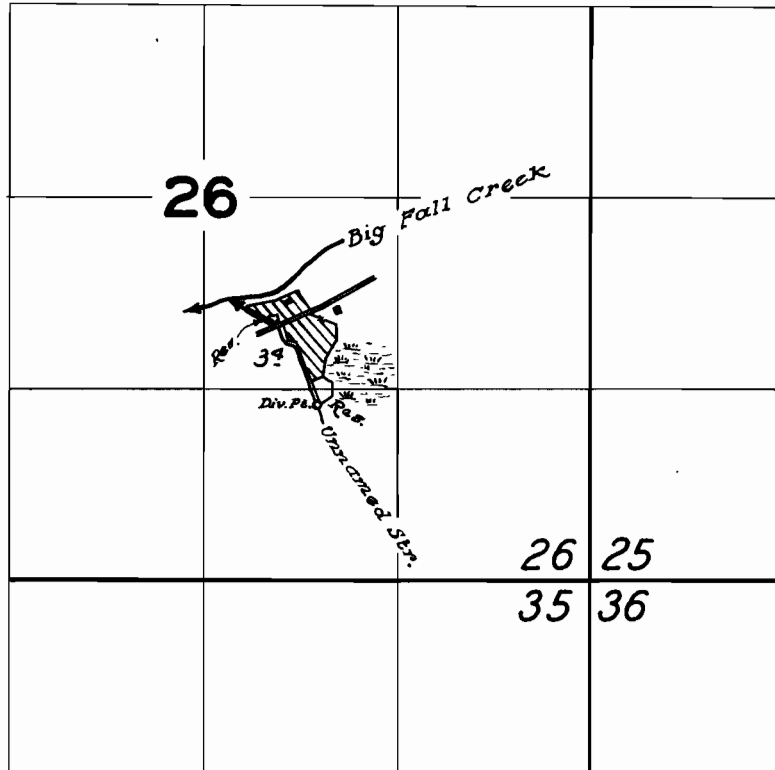

FINAL PROOF SURVEY UNDER

Application No. ^{R-31874} 31875..... Permit No. ^{R-2074} 25125.....
IN NAME OF

JESS HAYDEN

Surveyed May 12, 1960, by RH Jackson