


T.18S.R.2E.W.M.

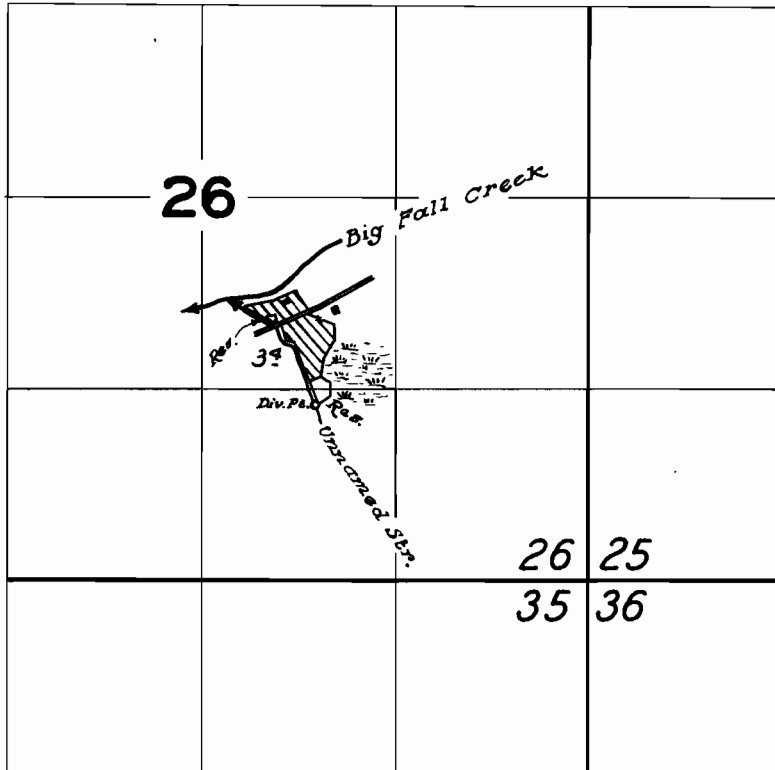

FINAL PROOF SURVEY UNDER

Application No. R-31874 31875..... Permit No. R-2074 25125.....
IN NAME OF

JESS HAYDEN

Surveyed May 12, 1960, by RH Jackson