


T.18S. R.1W.W.M.

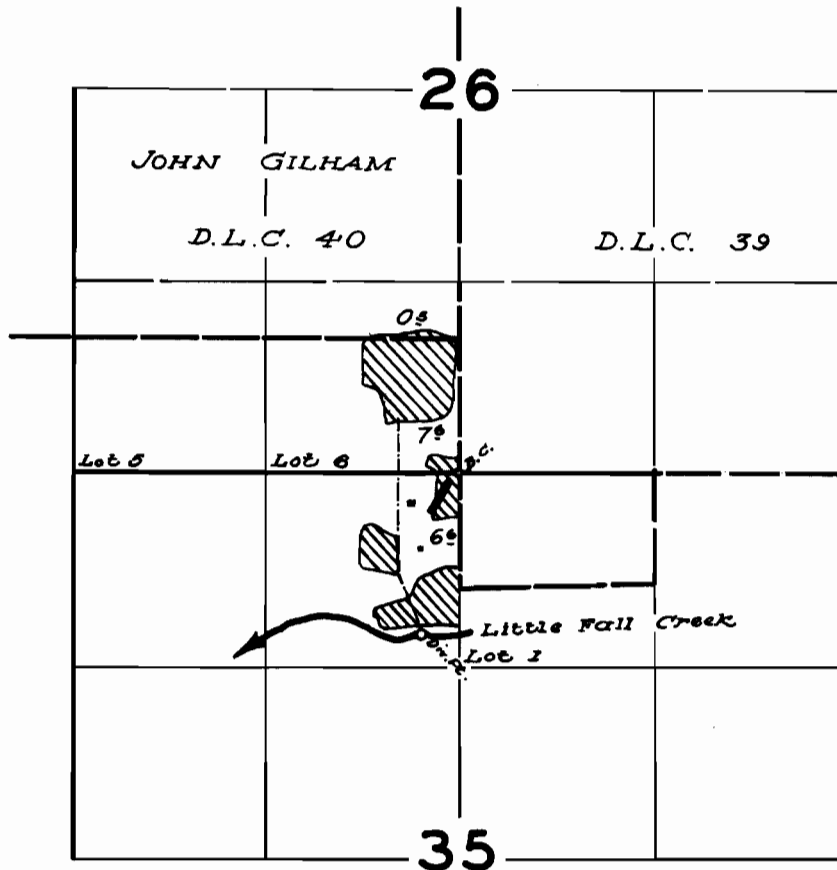

FINAL PROOF SURVEY
UNDER

Application No. 31935... Permit No. 25180...
IN NAME OF

A. C. SWANSON

Surveyed May 4, 1960, by R. Jackson