


T.18S. R.2 & 3 W.W.M.

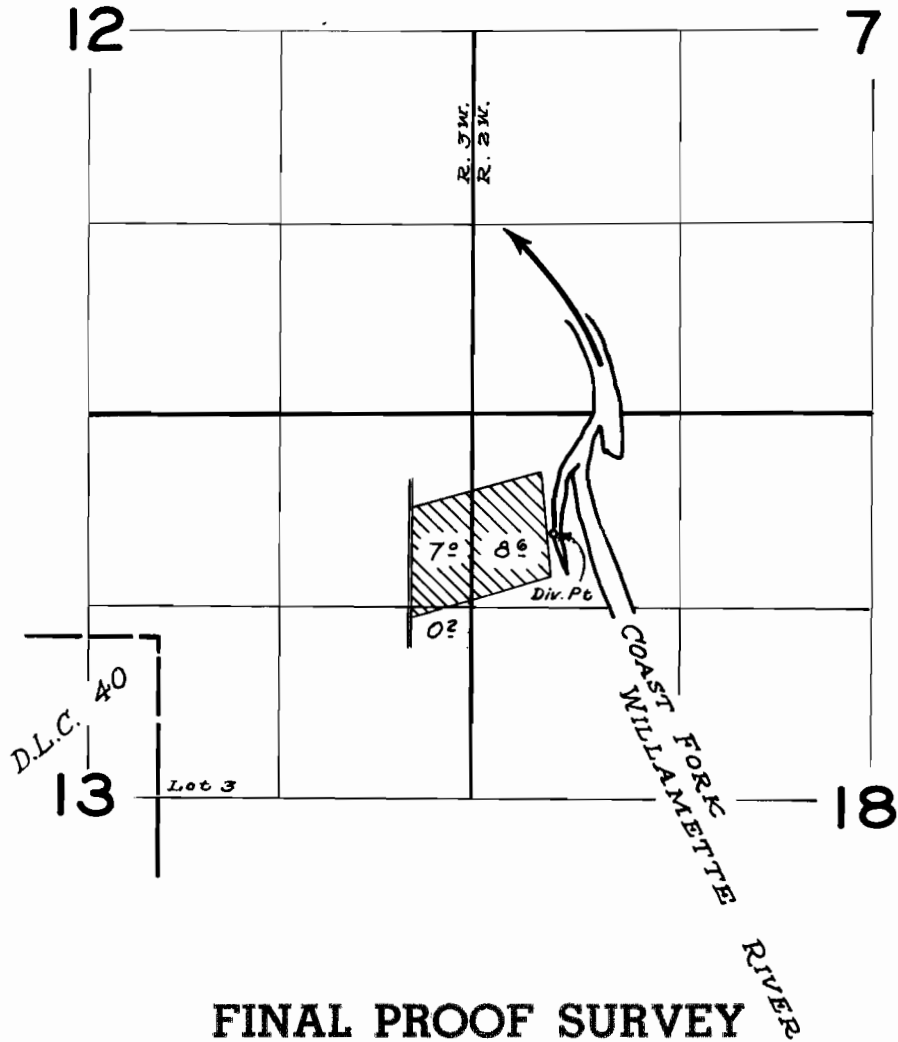

FINAL PROOF SURVEY
UNDER

Application No. 322.80. Permit No. 255.43.
IN NAME OF

WILLIAM HOBART SMITH

Surveyed May 2, 1960, by *R. Jackson*