


T.15S.R.4W.W.M.

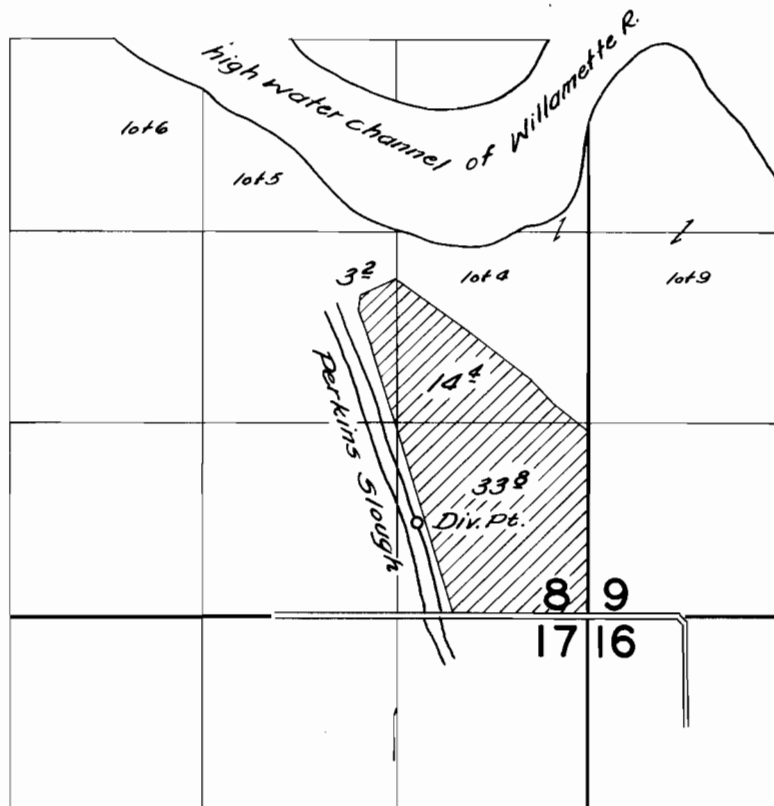

FINAL PROOF SURVEY UNDER

Application No. 32499 Permit No. 25679
IN NAME OF

W. R. McMullen

Surveyed April 26 1960, by C. O. Barlow