


T.18S.R.2W.W.M.

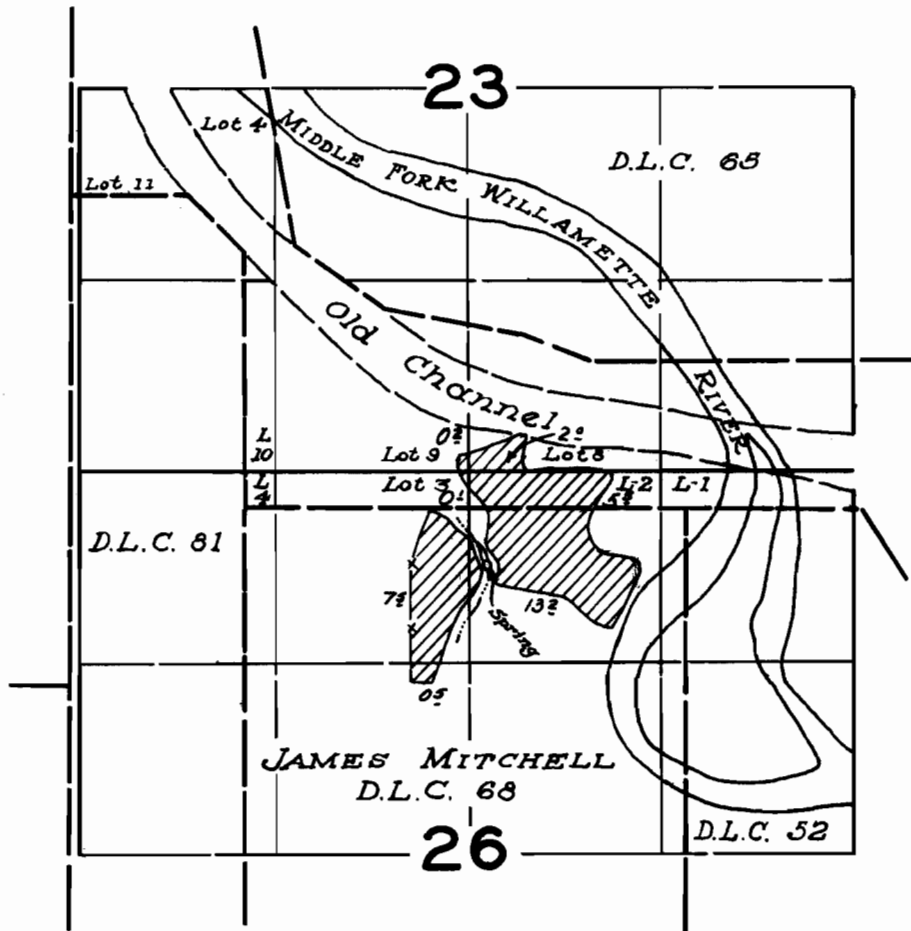

**FINAL PROOF SURVEY**  
UNDER

Application No. 32830... Permit No. 25910...  
IN NAME OF

**L. W. TENNIS**

Surveyed May 4... 1960, by *R. Jackson*