


T.18S.R.1W.W.M.

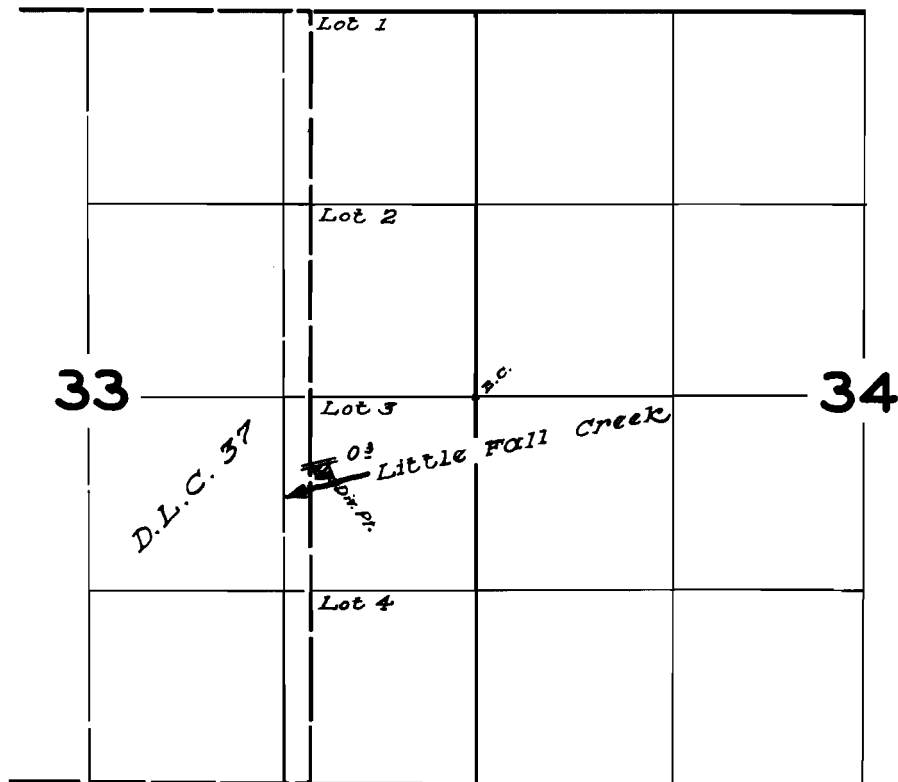

FINAL PROOF SURVEY
UNDER

Application No. 32685... Permit No. 25993...
IN NAME OF

GEORGE L. BREWER

Surveyed May 4, 1960, by

R. H. Jackson