T.10S. R. 9W.W.M.

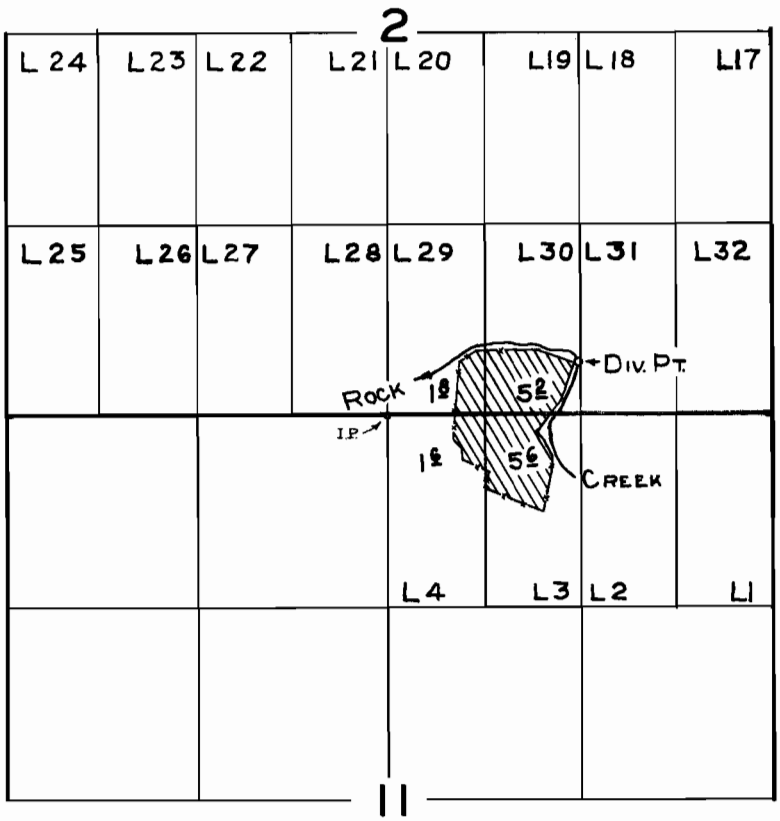

FINAL PROOF SURVEY
UNDER

Application No. 30679 Permit No. 24155
IN NAME OF

WALTER & HELEN BOWMAN

Surveyed AUG 16 1960, by M. BISH

1960-E