


T.6S. R. 10W.W.M.

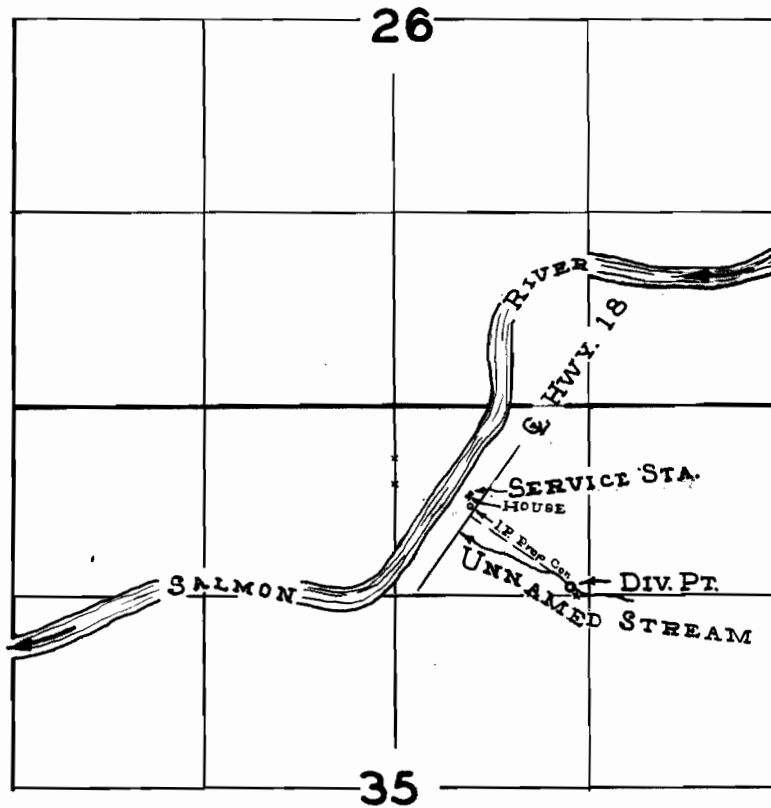

FINAL PROOF SURVEY UNDER

Application No. 33909... Permit No. 26715...
IN NAME OF

.....JOHN L. OSTENDORP.....

Surveyed Aug. 9... 1960, by M. BISH.....