


T.10S.R.3W.W.M.

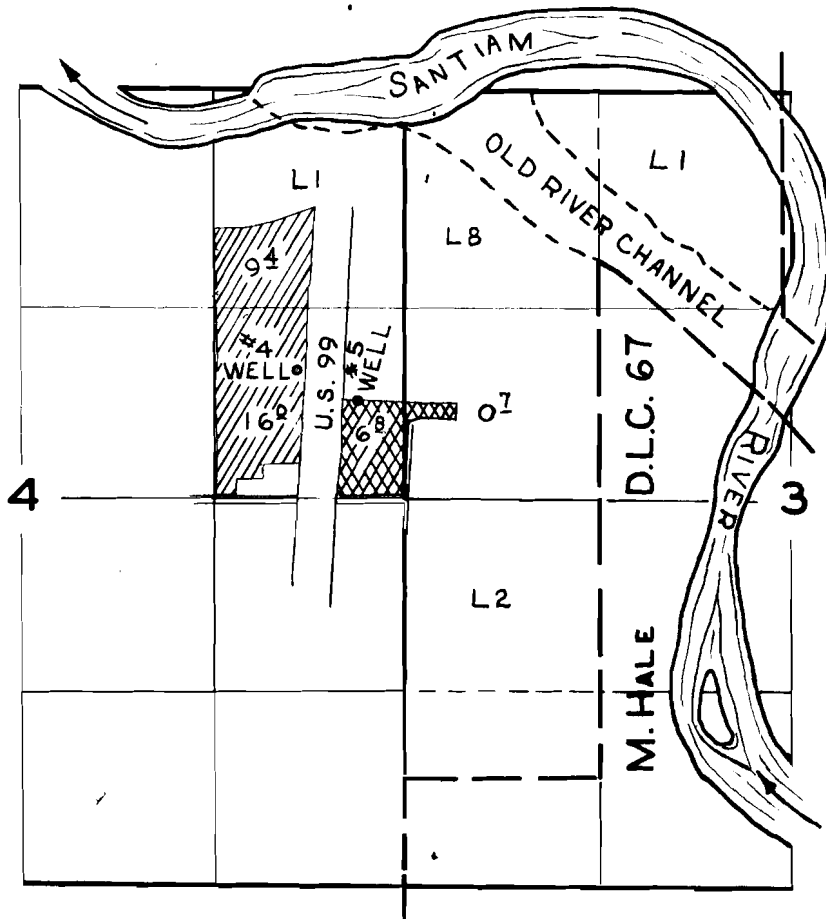

**FINAL PROOF SURVEY**

UNDER

WELL #4



WELL #5



G 1622

G 1491

Application No. G 595..... Permit No. G 514.....

IN NAME OF

**HENRY & PAULINE TURNIDGE**  
**ELTON I. & MILDRED HIGBEE**  
 Surveyed **JUNE 22 1960**, by **M. BISH**.....