


T.10S. R.3W.W.M.

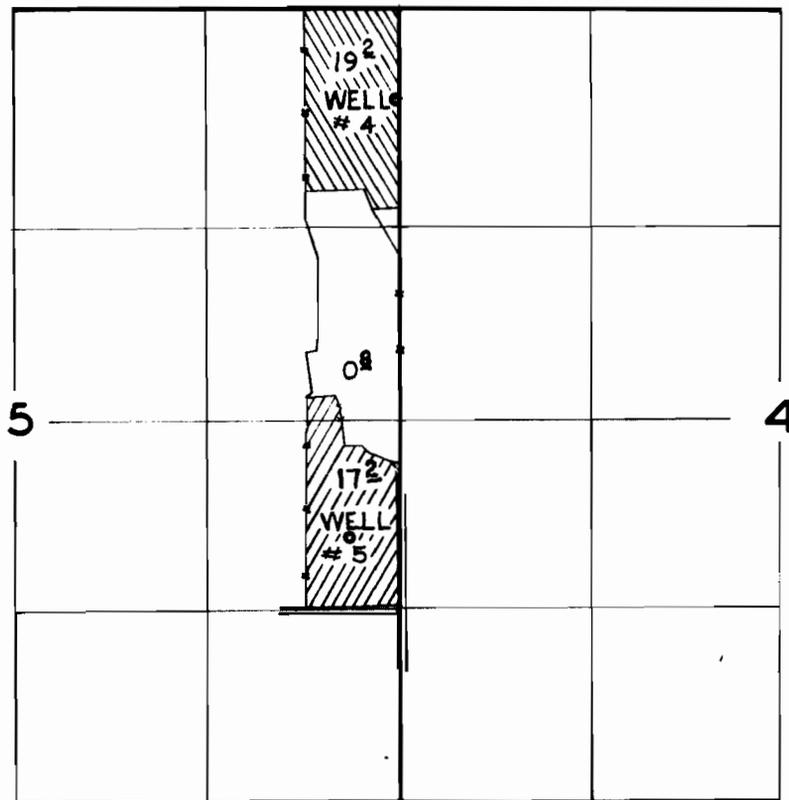

FINAL PROOF SURVEY
UNDER

WELL  WELL 

Application No. G-1369 Permit No. G-1244
G-1370 G-1245
IN NAME OF

.....MYRON BALLARD INGRAHAM.....

Surveyed JUNE 23 1960, by M. BISH.....