


T.10S.R.3W.W.M.

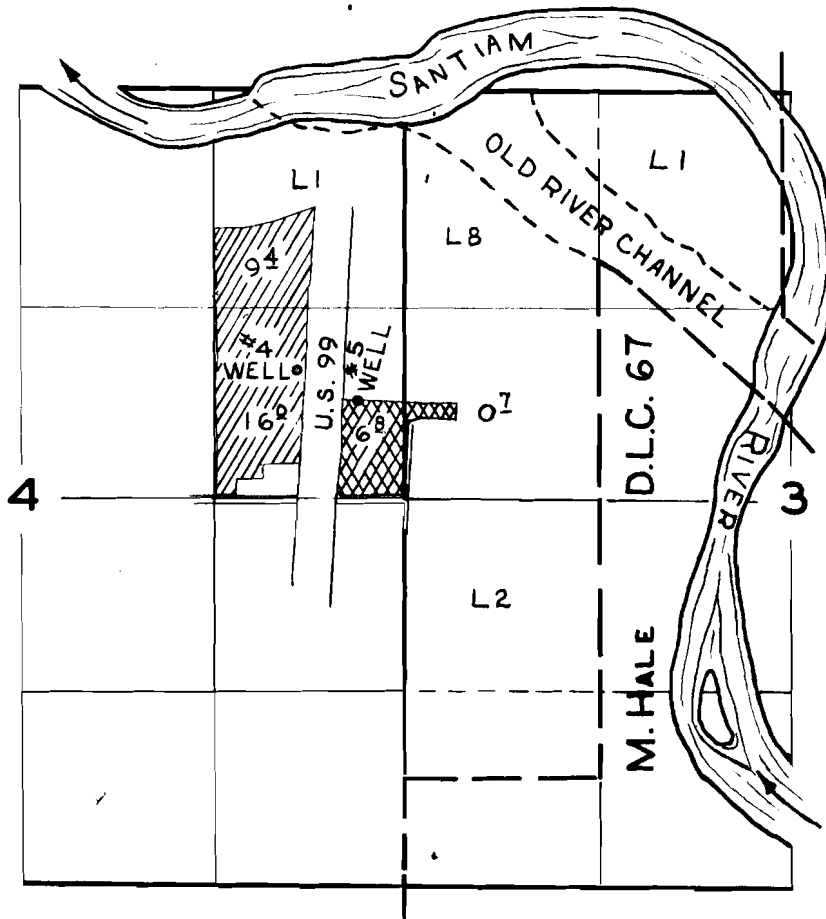

FINAL PROOF SURVEY

UNDER

WELL #4



WELL #5



G 1622

G 1491

Application No. G 595..... Permit No. G 514.....

IN NAME OF

HENRY & PAULINE TURNIDGE
ELTON I. & MILDRED HIGBEE
 Surveyed **JUNE 22 1960**, by **M. BISH**.....