


T.10S. R.2W.W.M.

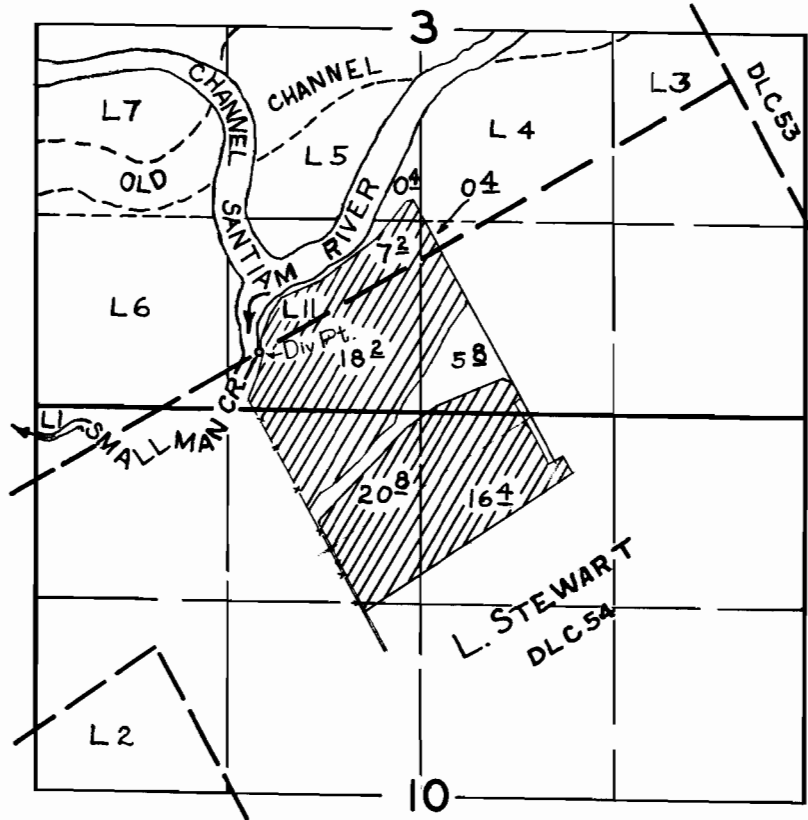

**FINAL PROOF SURVEY**  
UNDER

Application No. 30718... Permit No. 24124...  
IN NAME OF

HARLAN & HELEN EASTMAN

Surveyed JULY 6, 1960, by M. BISH