


# T.10S. R.1W.W.M.

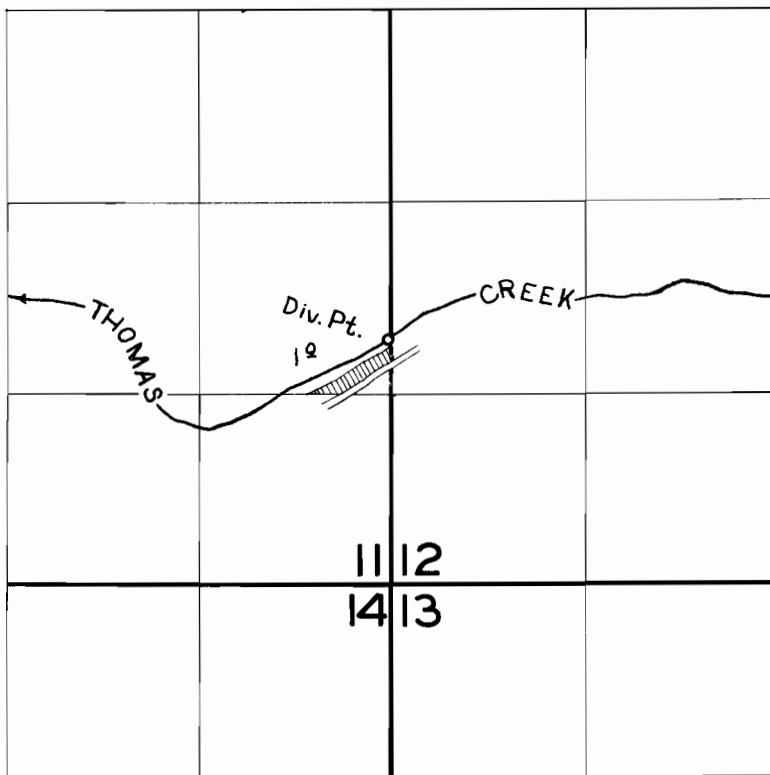

## FINAL PROOF SURVEY UNDER

Application No. 30827... Permit No. 24266..  
IN NAME OF

.....FRANK P. & HELEN E. SACHET.....

Surveyed JUNE 24 1960, by M. BISH.....