


T. 8 S. R. 1 W. W.M.

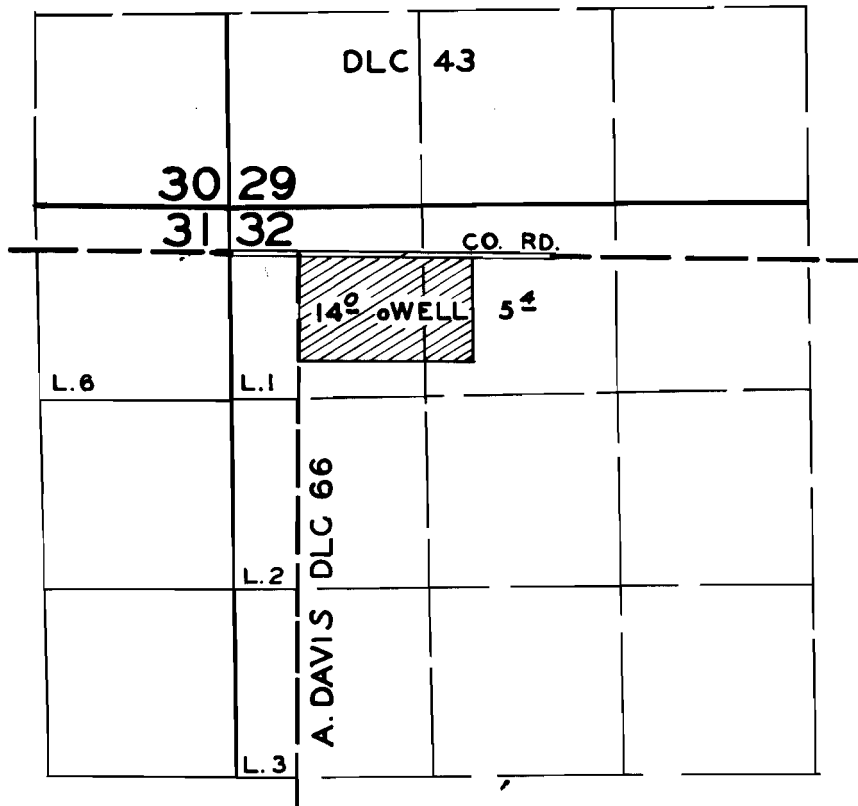

FINAL PROOF SURVEY
UNDER

Application No. G. 393 Permit No. G. 265
IN NAME OF

..... DANIEL J. ELBERT

Surveyed MAY 18 .. 1960 .., by C. O. BARTELS