


T. 6 S. R. 2 W. W.M.

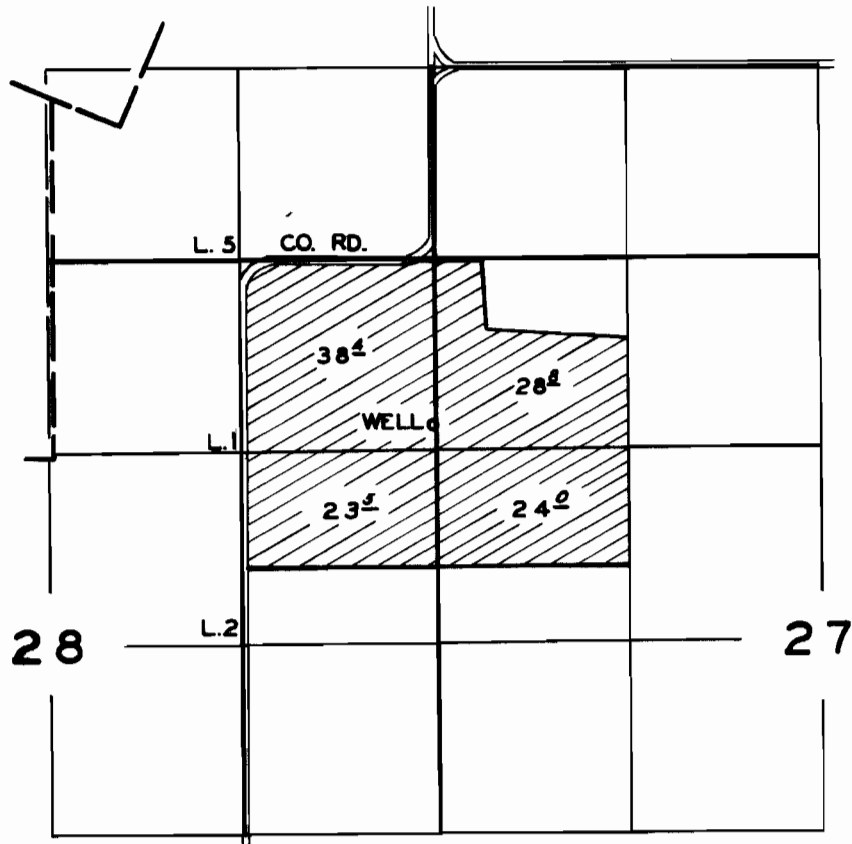

FINAL PROOF SURVEY
UNDER

Application No. G475..... Permit No. G.352.....
IN NAME OF

..... W.H. WILLIAMSON

Surveyed MAY. 25. 19.60., by G.O. BARTELS...