


T. 5S. R. 2W. W.M.

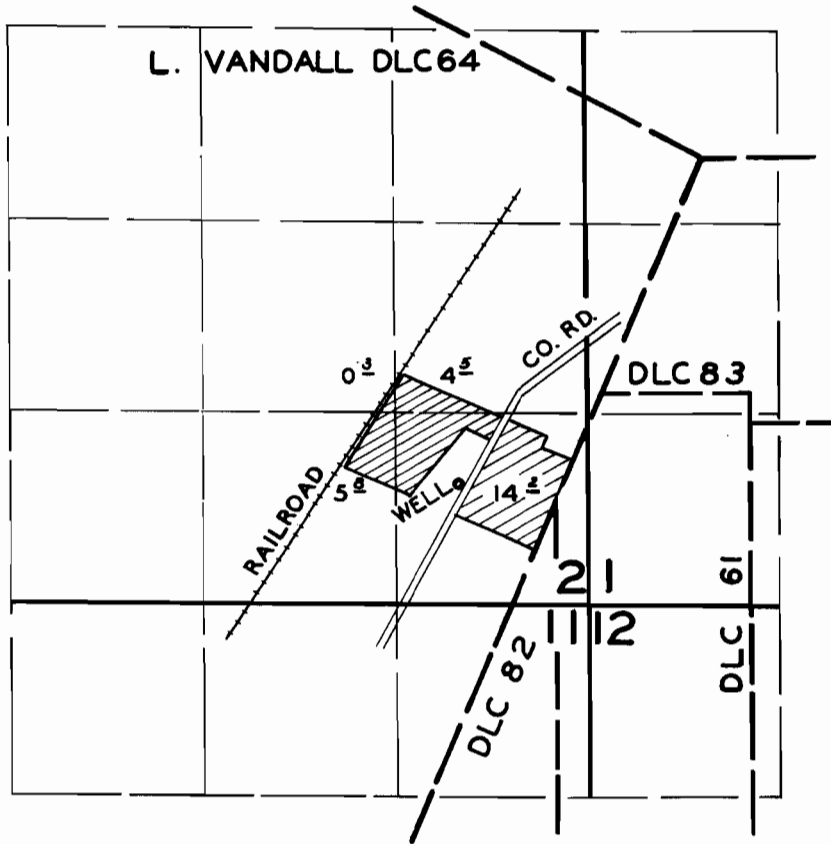

FINAL PROOF SURVEY
UNDER

Application No. G.533..... Permit No. G.430.....
IN NAME OF

.....SCOTT G. BAKER.....

Surveyed MAY 23 1960, by C.O. BARTELS.....