


T. 9S. R. 1W. WM.

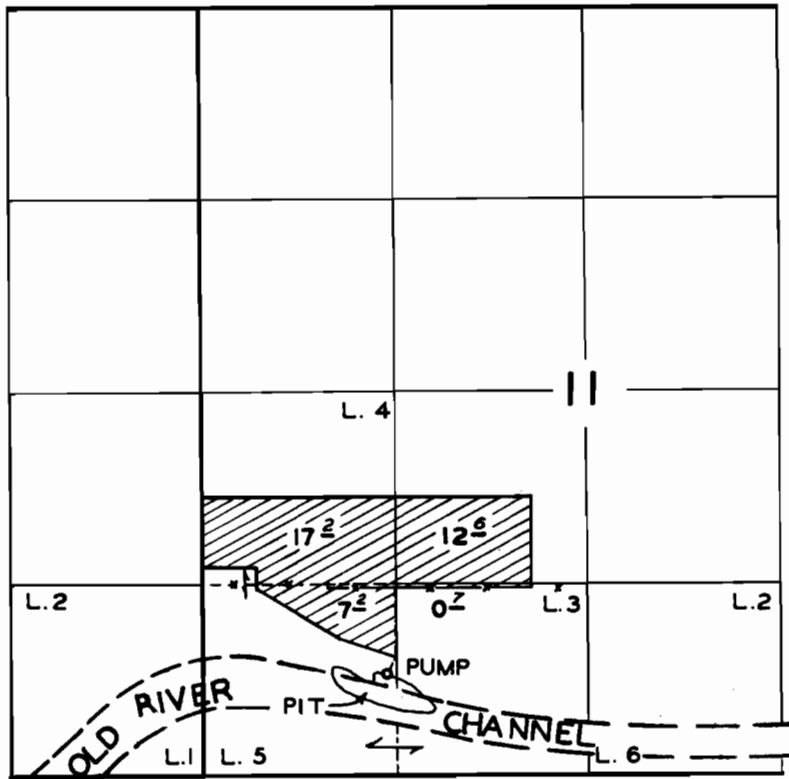

FINAL PROOF SURVEY
UNDER

Application No. G 632 Permit No. G.552
IN NAME OF

CHRIS E. NEITLING

Surveyed MAY 16 1960, by G. O. BARTELS