


T. 7S. R. 2W. W.M.

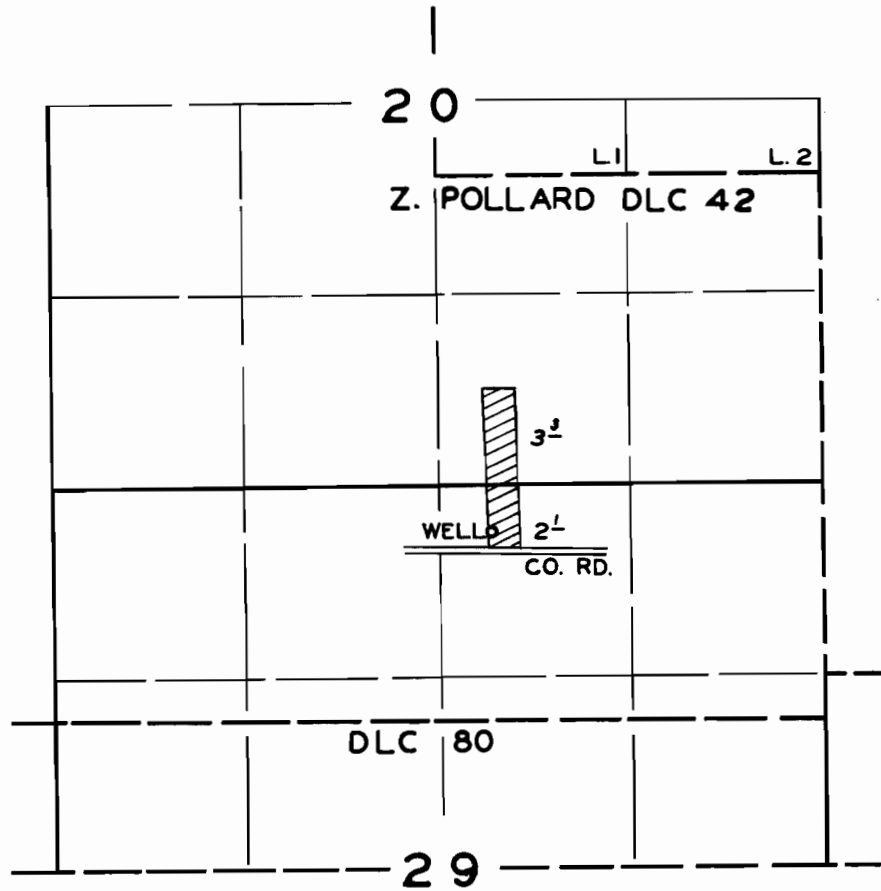

FINAL PROOF SURVEY
UNDER

Application No. G. 660 Permit No. G. 589
IN NAME OF

..... F. D. PALMER

Surveyed MAY 25 1960, by G. O. BARTELS