


T.6 S.R.I.E.W.M.

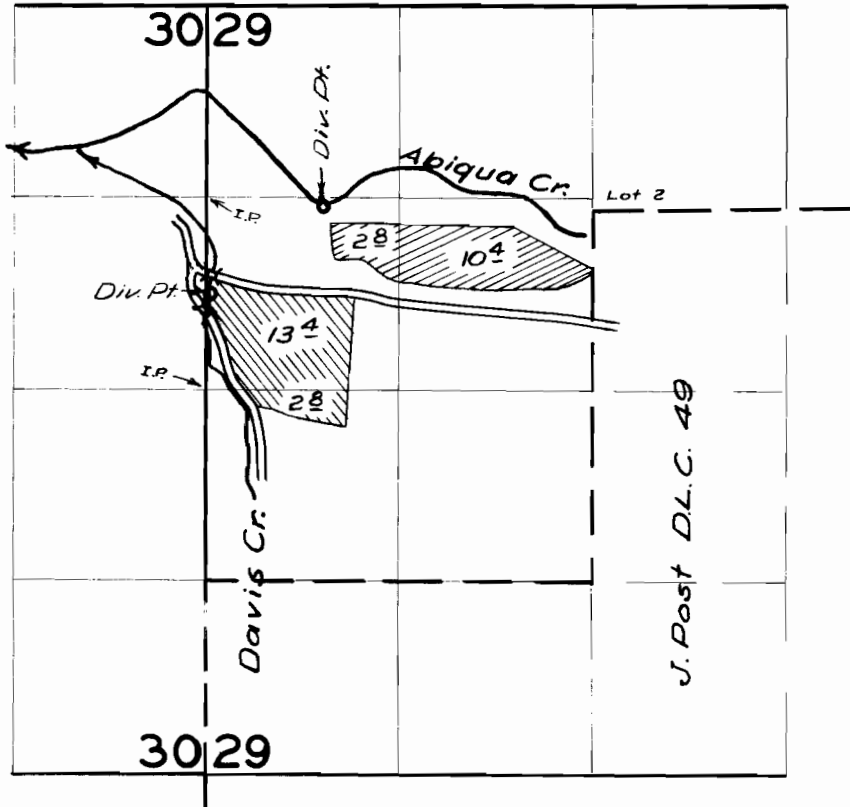

FINAL PROOF SURVEY UNDER

Application No. 25089 Permit No. 20495
IN NAME OF

MERVIN TEGLAND

Surveyed 20 April 1960 by M. B. Bish