


T.7 S.R.I.E.W.M.

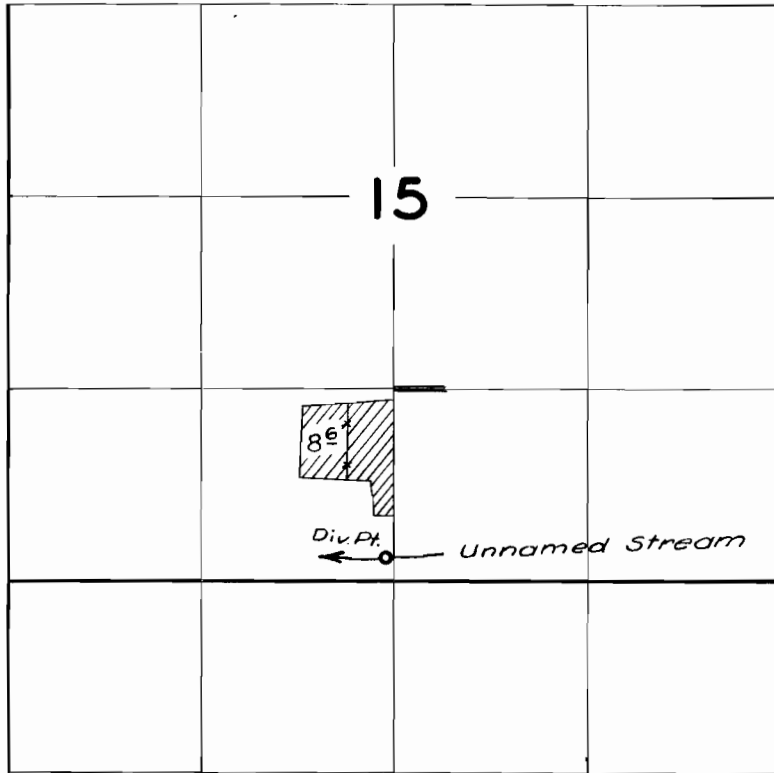

FINAL PROOF SURVEY UNDER

Application No. 29711 Permit No. 24158
IN NAME OF

GORDON BRENNEMAN

Surveyed 20 April 1960 by W. B. Bish